

**CITY OF MILPITAS
MILPITAS SENIOR CENTER
REPAIR AND RESTORATION PROJECT, PHASE 2**

**160 MAIN STREET
MILPITAS, CALIFORNIA**

GENERAL NOTES

1. THE OWNER, ARCHITECT, AND ENGINEER WILL ASSUME NO RESPONSIBILITY FOR VARIANCES BETWEEN ACTUAL EXISTING CONDITIONS AND CONDITIONS DEPICTED AS EXISTING ON THE DRAWINGS. THE CONTRACTOR SHALL INSPECT THE BUILDING, AND SHALL VERIFY TO HIS OWN SATISFACTION THE CONDITIONS THEREOF. IF CONDITIONS IN THE FIELD ARE AT VARIANCE WITH CONDITIONS SHOWN ON THE DRAWINGS AND MATERIALLY AFFECT THE GENERAL CONTRACTOR'S ABILITY TO DO THE WORK, HE SHALL IMMEDIATELY INFORM THE OWNER.

2. DRAWINGS OR NOTES DEPICTING EXISTING CONDITIONS HAVE BEEN DEVELOPED FROM FIELD INVESTIGATIONS UNDERTAKEN BY THE ARCHITECT AND ENGINEER. THE DRAWINGS AND NOTES DEPICTING EXISTING CONDITIONS ARE INTENDED ONLY AS A MEANS OF PROVIDING THE CONTRACTOR A GENERAL SENSE OF EXISTING BUILDING CONDITIONS. THE OWNER, ARCHITECT, AND ENGINEER WILL ASSUME NO RESPONSIBILITY FOR VARIANCES BETWEEN CONDITIONS SHOWN ON THE DRAWINGS AS EXISTING AND ACTUAL FIELD CONDITIONS. THE CONTRACTOR SHALL ASSUME THAT THERE MAY BE MINOR DIFFERENCES BETWEEN CONDITIONS SHOWN ON THE DRAWINGS AS EXISTING AND ACTUAL FIELD CONDITIONS. THE OWNER WILL NOT CONSIDER REQUESTS FOR ADDITIONAL MONIES FROM THE CONTRACTOR DUE TO MINOR DISCREPANCIES BETWEEN CONDITIONS SHOWN ON THE DRAWINGS AS EXISTING AND ACTUAL FIELD CONDITIONS. IF MAJOR DIFFERENCES BETWEEN CONDITIONS SHOWN ON THE DRAWINGS AS EXISTING AND ACTUAL FIELD CONDITIONS ARE ENCOUNTERED BY THE CONTRACTOR, THE CONTRACTOR SHALL IMMEDIATELY INFORM THE OWNER AND ARCHITECT AND/OR ENGINEER AND SHALL STOP WORK IN THE AREA WHERE THE CONTRACTOR HAS ENCOUNTERED MAJOR DIFFERENCES BETWEEN CONDITIONS SHOWN ON THE DRAWINGS AS EXISTING AND ACTUAL FIELD CONDITIONS. THE OWNER, ARCHITECT, AND/OR ENGINEER WILL PROVIDE INSTRUCTIONS FOR PROCEEDING IN THE AREA WHERE THE CONTRACTOR HAS ENCOUNTERED MAJOR DIFFERENCES BETWEEN CONDITIONS SHOWN ON THE DRAWINGS AS EXISTING AND ACTUAL FIELD CONDITIONS IN A TIMELY MANNER. IF THE CONTRACTOR IS REQUIRED TO STOP WORK IN AN AREA DUE TO THE CONTRACTOR ENCOUNTERING MAJOR DIFFERENCES BETWEEN CONDITIONS SHOWN ON THE DRAWINGS AS EXISTING AND ACTUAL FIELD CONDITIONS HE SHALL PROCEED WITH ALL OTHER WORK ITEMS AS REQUIRED BY THE CONTRACT DOCUMENTS.

3. ALL WORK SHALL CONFORM TO ALL CURRENT CODES AND REGULATIONS INCLUDING BUT NOT LIMITED TO THE LATEST EDITION OF THE UNIFORM BUILDING CODE, OSHA, THE LATEST APPLICABLE SECTIONS OF THE STATE OF CALIFORNIA ADMINISTRATIVE CODE (INCLUDING APPLICABLE SECTIONS OF TITLES 19, 21, AND 24), AND ANY AMENDMENTS BY OTHER GOVERNING JURISDICTIONS.

4. ALL WORK SHALL CONFORM TO APPLICABLE REFERENCED STANDARDS AS ENUMERATED IN THE SPECIFICATIONS. SPECIFIC REFERENCED STANDARDS THAT SHALL BE COMPLIED WITH INCLUDE THE NRS ROOFING AND CLADDING ROOFING MANUAL, THIRD EDITION, AND SMACNA, ARCHITECTURE SHEET METAL MANUAL, LATEST EDITION, WHERE REFERENCED. STANDARD DETAILS HAVE BEEN MODIFIED AS SHOWN ON THE DRAWINGS, EXECUTE THE WORK IN ACCORDANCE WITH THE REFERENCED STANDARDS INCORPORATING THE MODIFICATIONS SHOWN ON THE DRAWINGS INTO THE WORK.

5. THE DRAWINGS IDENTIFIES MATERIALS BY GENERIC NAME.
FOR A DESCRIPTION OF APPROVED MATERIALS AND
INSTALLATION PROCEDURES SEE THE SPECIFICATIONS.

6. UNLESS OTHERWISE NOTED ON THE DRAWINGS OR IN THE SPECIFICATIONS THE SELECTION OF COLORS AND TEXTURES WILL BE FROM THE MANUFACTURER'S STANDARD FOR FINISH MATERIAL.

7. FOR SPECIFIC REQUIREMENTS REGARDING INSTALLATION OF BATT INSULATION SEE THE SPECIFICATIONS.

8. THE NOTES DESCRIBING THE SCOPE OF REQUIRED BUILDING REPAIRS ARE INTENDED AS A GUIDE TO OUTLINE THE NATURE AND EXTENT OF THE WORK. OTHER PARTS OF THE CONTRACT DOCUMENTS, INCLUDING THE DRAWINGS AND SPECIFICATIONS, MAY SHOW AND/OR REFERENCE WORK NOT INCLUDED IN THE NOTES. THE CONTRACTOR SHALL VISIT THE SITE AND EXAMINE THE CONDITIONS THERE AND THOROUGHLY ACQUAINT HIMSELF WITH ITS OBSTACLES AND ADVANTAGES FOR PERFORMING THE WORK, AND CAREFULLY REVIEW ALL DRAWINGS AND SECTIONS OF THE SPECIFICATIONS AS THERE ARE REQUIREMENTS SHOWN ON THE DRAWINGS AND CONTAINED IN THE SPECIFICATIONS THAT SIGNIFICANTLY AFFECT THE SCOPE OF WORK AS OUTLINED IN THESE NOTES. NO ADDITIONAL CHARGE(S) WILL BE ALLOWED FOR WORK CAUSED BY THE CONTRACTOR'S UNFAMILIARITY WITH THE SITE, AND THE DRAWINGS AND SPECIFICATIONS, OR FAILURE OF THE ARCHITECT TO ENUMERATE THE COMPLETE SCOPE OF REQUIRED REPAIRS, AS REQUIRED BY THE CONTRACT DOCUMENTS, IN THE ACCOMPANYING NOTES.

9. REFERENCE TO SPECIFICATION SECTIONS IN THE NOTES DESCRIBING THE SCOPE OF REQUIRED REPAIRS OR NEW WORK ARE INTENDED AS A GUIDE ONLY AND TO ASSIST THE CONTRACTOR IN UNDERSTANDING THE COMPLETE SCOPE OF THE WORK. IT IS ASSUMED THAT OTHER SECTIONS OF THE SPECIFICATIONS THAT ARE NOT REFERENCED MAY CONTAIN REQUIREMENTS AFFECTING THE WORK.

10. SEE DIVISION 1 FOR SPECIFIC REQUIREMENTS RELATED TO PATCHING OF EXISTING CONSTRUCTION.

DRAWING LIST

101 TITLE SHEET
A-1 ROOF DEMOLITION PLAN
A-2 FLOOR PLAN
A-3 ROOF PLAN
A-4 REFLECTED CEILING PLAN
COURTYARD AND CORRIDOR
A-5 EXTERIOR ELEVATIONS - WEST
A-6 EXTERIOR ELEVATIONS
EAST, NORTH, SOUTH
A-7 EXTERIOR AUDITORIUM ELEVATIONS
SOUTH, WEST
A-8 EXTERIOR ELEVATIONS AND PLANS
COURTYARD, EXTERIOR STAIRS AND RAMPS
A-9 ROOF DETAILS, SCUPPER PLAN DIAGRAMS
A-10 ROOF AND GUTTER DETAILS
A-11 ROOF DETAILS
MECHANICAL EQUIPMENT SCREENS AND DETAILS
A-12 ROOF DETAILS AND MISCELLANEOUS DETAILS
M-1 MECHANICAL PLAN

C1 SITE DRAINAGE PLAN
C2 DETAILS

S1.1 GENERAL NOTES & TYPICAL DETAILS
S2.1 FOUNDATION PLAN & DETAILS
S3.1 ROOF FRAMING PLAN & DETAILS
S4.1 FRAMING DETAILS
S4.2 FRAMING DETAILS
S5.1 SPECIFICATIONS
S5.2 SPECIFICATIONS
S5.3 SPECIFICATIONS

LEGEND

1.1 REFERENCES SCOPE AND NOTES
INTERIOR RENOVATIONS

1.E REFERENCES SCOPE AND NOTES

1.R REFERENCES SCOPE AND NOTES

1.D REFERENCES SCOPE AND NOTES

DETAIL OR SECTION REFERENCE

07110.10 MATERIAL NOTE

NOTE NUMBER

	SPECIFICATION	SECTION	REFERENCE
1.0	1.0	1.0	1.0
2.0	2.0	2.0	2.0
3.0	3.0	3.0	3.0
86.0	86.0	86.0	86.0
87.0	87.0	87.0	87.0</

SITE PLAN



BUILDING DATA

BUILDING TYPE TYPE VN, SPRINKLERED

OCCUPANCY AUDITORIUM, A3
REMAINDER, B2

RECORD DRAWINGS - NOTES AND LEGEND

1. THE DRAWINGS HAVE BEEN ANNOTATED TO REFERENCE RELEVANT CONTRACTOR SHOP DRAWINGS AND PRODUCT DATA SUBMITTALS, SUPPLEMENTAL AND REVISED DETAILS ISSUED DURING THE CONSTRUCTION PHASE, AND OTHER INFORMATION CONTAINED IN THE PROJECT RECORD BUT NOT SHOWN ON THE DRAWINGS. INFORMATION CONTAINED ON THE REFERENCED DOCUMENTS HAS NOT BEEN TRANSFERRED TO THE DRAWINGS.

2. THE RECORD DRAWINGS DATED 4-1-93 ARE NOT "AS BUILT" DRAWINGS. IN THE PREPARATION OF THESE RECORD DRAWINGS NO ATTEMPT HAS BEEN MADE TO VERIFY THAT CONDITIONS AS DEPICTED ON THE DRAWINGS CORRESPOND TO ACTUAL BUILT CONDITIONS, AND NO ATTEMPT HAS BEEN MADE TO VERIFY THAT ITEMS SHOWN ON CONTRACTOR'S SUBMITTALS ARE ACTUALLY INSTALLED AS DESCRIBED ON THE SUBMITTAL DATA.

 SUPPLEMENTAL SKETCH NUMBER

A-2 **RELATED DRAWING NUMBER**

7a SUPPLEMENTAL OR REVISED DETAIL

542 DRAWING NUMBER FOR ORIGINAL DETAIL OR RELATED DETAILS

SDT-II **INDICATES SHOP DRAWING TRANSMITTAL NUMBER**

REF-1 INDICATES REQUEST FOR INFORMATION NUMBER

XXXXXX INDICATES OTHER NOTES ADDED FOR RECORD DRAWINGS


GROSSMANN DESIGN GROUP
ARCHITECTURE PLANNING RESEARCH

**CITY OF MILPITAS
MILPITAS SENIOR CENTER
Repair and Restoration Project
Phase 2
Project 3368**

[illegible]

10	7	0
DRAWN J G	DATE 7/17/91	
CHECK J G	JOB NO. 0020 010	
SHEET 101		

2-913

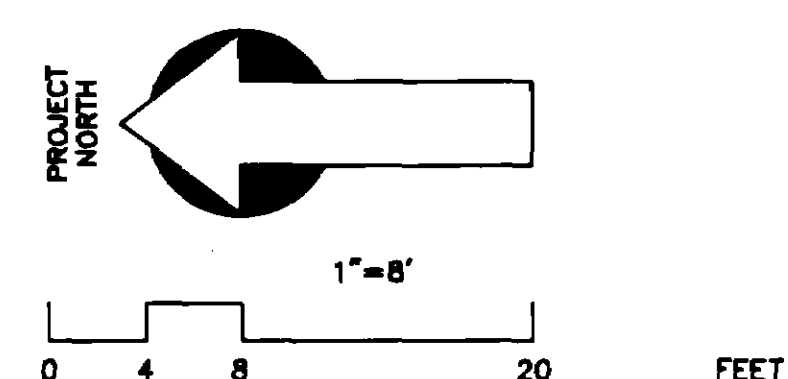

General: For related notes and additional work related to the scope of work depicted on this drawing, see the entire project drawings and specifications.

- 1.D Remove all existing wood sleepers set in mastic on the existing roof.
- 2.D Remove existing supports under existing electrical conduits (2). Temporarily support the existing conduits until new supports are installed.
- 3.D Remove all existing abandoned pipes, ducts, other miscellaneous mechanical items, and supports. Cap existing pipes, and ducts at parapet or in the interior of the building if required.
- 4.D Remove and protect existing HVAC Unit for future reinstallation at a new location. Remove existing wood support framing, ducts, temporarily cap ducts and electrical conduit as required.

Relocate existing electric conduit stub-ups through the roof and relocate existing associated disconnect switches. Reconnect power, interlock, and control wiring.

5.D Remove and protect existing mechanical equipment (cooler, exhaust hood, etc.) for future reinstallation. Temporarily cap ducts and electrical conduit as required. See Note 4.D for related electrical work.

6.D Remove existing skylights and curbs.

7.D Remove existing wood windows on south side of Auditorium and wood framing as required to install new wood windows.

8.D Existing roof vents shall remain and be protected from damage.

9.D Remove existing freon lines. See Sheet M-1.

10.D Remove all existing electrical conduit and wood supports. Removed cable and conduit shall not be reused.

All existing electrical conduits that are now running on top of the existing roof shall be relocated, unless otherwise noted, below the existing roof and shall be routed in the attic space or above the acoustical ceiling tile. Unused electrical conduits and stub-outs shall be removed. Remove all unused existing electrical equipment and devices, unless otherwise noted on the drawings.

The existing fan coil units are fed by branch circuit wiring which is located on top of the existing roof. The branch circuit wiring conduits traverse the top of the existing roof and drop down through the roof at locations adjacent to refrigeration piping drops. This branch circuit wiring shall be removed and new branch circuit wiring shall be installed in the attic space or above the acoustical ceiling tile. Reconnect power, interlock and control wiring to existing conduits inside the building.

11.D Remove existing panel boxes. See Note 10.D.

12.D Remove existing small cricket and ridge.

13.D Remove existing drain scuppers.

14.D Remove existing metal ducts, fans, and wood supports.

15.D Remove existing TV antenna and reinstall after completion of all roofing work. Provide new supports as required.

16.D Remove the existing electrical conduit. See notes regarding exterior work.

17.D Remove all existing drains, scuppers, and downspouts.

18.D Remove existing cement plaster on parapet walls.

19.D Existing electrical conduit to remain.

20.D Existing gas line to remain. Existing gas service piping bonding to electrical service ground shall remain.

21.D Existing sprinkler line to remain.

<p>CITY OF MILPITAS MILPITAS SENIOR CENTER Repair and Restoration Project Phase 2</p> <p>Project 3368</p>	<p>GROSSMANN DESIGN GROUP ARCHITECTURE PLANNING RESEARCH 151 Townsend Street San Francisco, CA 94107</p> <p>415-543-8618</p>
---	---

**CITY OF MILPITAS
MILPITAS SENIOR CENTER
Repair and Restoration Project
Phase 2
Project 3369**


[illegible]

A-1

2-913



- 1.1. Patch and prepare exterior interior surfaces of existing wood windows not to be replaced in Room 101, Auditorium. Patch existing exterior interior surfaces of existing wood windows. Replace broken glass and repair glazing sealant as required. See specification Sections 08800 GLAZING and 09900 PAINTING.
- 2.1. Remove existing door and frame to Room 104, Office. Reframe existing opening with 2 x 4 wood studs. Provide new interior and exterior finishes as required to match existing exterior and interior walls. Add floor base at interior as required to match existing. Patch and prepare existing walls for painting as required. Paint exterior wall where new finish has been provided and entire surface of wall in Room 104, Office, where new finishes have been installed. See specification Sections 02060 DEMOLITION, 06100 ROUGH CARPENTRY, 09220 CEMENT PLASTER, and 09900 PAINTING.
- 3.1. Repair and patch existing walls as required to prepare for painting in Room 109, Vestibule. Paint existing walls and trim in Room 109, Vestibule. See specification Section 09900 PAINTING.
- 4.1. Install ~~new~~ new light fixtures in Room 111, Womens Toilet, over the existing lavatories. Light fixtures shall be Lightlifter "Lumiframe" II, #10477, matte white with 2-40W lamps. Height of new light fixture over lavatories shall be 6'-6" above finished floor. Install 1 new light fixture in Room 111, Womens Toilet, in the existing handicapped stall. Light fixture shall be Lightlifter "Lumiquad", #6783, light white with compact fluorescent lamp. See DIVISION 16 of the specifications. SEE SGT-5 (2-3)
- 5.1. Remove existing finishes as required by structural work. Provide new gypsum wallboard and paint finish. Provide new bases to match existing. See specification Sections 02060 DEMOLITION, 09250 GYPSUM BOARD CONSTRUCTION, 09900 PAINTING, and DIVISION 1.
- 6.1. Electrical Work:
- All conduits in new construction shall be installed concealed, unless otherwise noted. If new conduits, boxes, devices, etc. are to be installed on existing construction, exposed installation is allowed to match existing.
- Where existing outlets are shown to remain, the contractor shall provide extension collars as required. Install new conduit and wiring where needed to maintain continuity of existing circuits.
- The exact location of conduit stub-ups, outlet box locations, etc. for equipment shall be coordinated with equipment requirements.
- 7.1. Provide new wheel chair lift in existing Room 101B, Storage as follows:
- Remove existing stage level floor and floor joists in Room 101B. Remove shelving, closet poles and similar items. Remove existing door to upper stair landing. Remove existing finishes and wall framing at new openings to stage and lower stair landing.
- Provide new wood studs at removed door. Provide additional studs and other framing as required to support edge of stage floor where chair lift fasten panel and new wall to match existing woodwork. Provide resilient floor. Provide 4 x 6 (minimum) headers and studs as required to frame new openings. Provide framing for ramp to new wheel chair lift. Install new 1/2" exterior grade plywood over existing diagonal floor sheathing, Douglas Fir, 15/32 5-ply CDX, PSI-83.
- Relocate electrical convenience outlet at new opening to stage as shown on Drawings. Relocate light switch for Room 101B as shown on Drawings unless existing light is switched at panel only.
- Provide new thermal insulation at exterior walls.
- Provide new interior wall finish below stage level and at removed door to match existing wall finish. Patch and prepare existing walls for painting as required. Submit proposed wall finish and patching materials and methods to Owner and/or Architect for review.
- At new openings provide wood casing and trim to match existing adjacent openings at stage and lower stair landing.
- Provide 1/4" (minimum) underlayment and new 1/8" gauge sheet vinyl resilient floor finish similar to existing Auditorium floor finish in existing Room 101A. Provide new floor finish in accordance with Resilient Floor Covering Institute Standard Specifications. Difference in level between new and existing finish floor shall not exceed 1/4". Provide suitable transition strip where new floor joins existing. Submit manufacturer's literature and samples of flooring materials to Owner and/or Architect for review.
- Install wood floor base to match existing wood base in auditorium and stair landing.
- Paint all walls in Room 101B and entire east wall of adjacent stairwell, 2 coats minimum.
- Provide new electrically operated vertical wheelchair lift, "Porch-lift" PL-S50 as manufactured by American-Stair-Glide-Corporation. Provide with top landing gate, platform gate, access ramp, vertical fascia, and call-send controls for top and bottom landings. Controls shall have emergency stop buttons and shall be interlocked so that lift will not operate if either gate is open. Provide base modifications and anchors as required for installation on wood floor. Furnish and install in accordance with details on Drawings and manufacturer's specifications. Provide junction box(es) and power as required from existing panel in adjacent stairwell. Provide dedicated circuit for wheel chair lift equipment. Submit shop drawings for review by Owner and/or Architect. NATIONAL WHEELCHAIR LIFT CO., SEE SGT-9B
- See specifications Sections 02060 DEMOLITION, 06100 ROUGH CARPENTRY, 06200 FINISH CARPENTRY, 07200 BUILDING INSULATION, 09900 PAINTING, DIVISION 16 ELECTRICAL and DIVISION 1.
- 8.1. Provide new Poplar or Birch wood curb and trim at edge of stage as shown on Drawings. Remove existing metal trim and resilient flooring at stage. Install new curb. Paint curb to match existing woodwork. Provide vinyl inside cove moulding, Mercer No. 655 or approved equal. See specifications Sections 06200 FINISH CARPENTRY and 09900 PAINTING.
- 9.1. Remove existing exit signs and switches and provide new exit signs with back-up batteries at exit doors where indicated. New exit signs shall not be switched. Provide Hubbell "Freedom Series LED" exit signs as follows: Signs shall be illuminated by green light emitting diodes (LED), AC powered with sealed lead acid battery back-up for two hours minimum. Provide flasher, beeper and dual rated 120/277 volt primary connections. Housing shall be black with a 125" thick clear polycarbonate panel over the face plate. Units shall be UL listed with minimum 5 year warranty. See specifications DIVISION 16 ELECTRICAL. SEE SGT-5(4) 9.1X EXIT LIGHT ADDED, NO MFR DATA
- 10.1. Remove existing door and trim, and install a new door at Storage 101A. Provide new wood framing, and new wall finish and base to match the existing wall finishes to fill in the opening. Remove existing wall finish and framing as required to install a new door at the stage. Provide new wood framing as required to frame the new opening for the new door. Relocate existing electrical outlet and patch wall as required at new door opening.
- Install new 3'-0" x 6'-8" door and frame to match removed door. New door shall conform to applicable AWI or WIC standards, minimum grade custom. Provide new door frame and trim to match existing. Patch existing resilient flooring as required. Paint entire east and west walls of north stairwell, entire west wall of south stairwell, entire west and south walls of Room 101A, and entire north and south walls of stage, 2 coats minimum at previously painted areas. Door hardware shall be as follows:
- Lock: Schlage D Series with "Olympiad" lever.
- Cylinder: As directed by the Owner to match the existing keying system.
- Hinges 1 1/2 pair butts, full mortise.
- Closer: LCN delayed action 4041 "Super Smoothies".
- Submit shop drawings for review by Owner and/or Architect. See specifications Sections 02060 DEMOLITION, 06100 ROUGH CARPENTRY, 06200 FINISH CARPENTRY, 09900 PAINTING, DIVISION 16 ELECTRICAL and DIVISION 1.
- 11.1. Provide new handrails at north and south stage stairways as follows: Remove existing handrails and brackets. Remove existing exposed electrical conduit, wiring, and light fixture at south stairway. Patch and prepare walls as required. Install new bronze (CDA 385) handrails and handrail brackets on both sides of both existing stairways at the stage. Handrail mouldings shall be similar to Julius Blum & Co., Inc. 4531 except maximum width shall be 1 1/2 inches to comply with ADA. Handrails shall be located minimum of 32 inches apart and shall be of a decorative type approved by the Owner and/or the Architect. Install handrails to maintain 1 1/2 inch clearance between hand moulding and walls and/or wood trim. Bend handrail around panelboard as required at north stairway. Return ends to wall.
- SEE SGT-3B
- 12.1. PROVIDE NEW THERMAL INSULATION OVER ALL EXTERIOR SPACES. SEE 07200 BUILDING INSULATION. SEE SGT-8

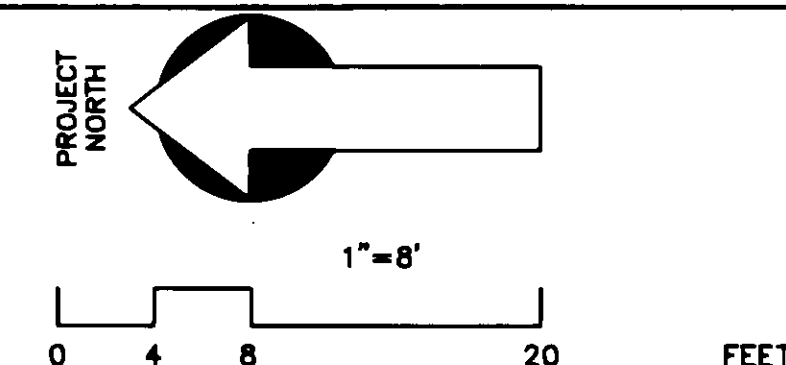

RECORD DRAWING
4-1-93

<p>CITY OF MILPITAS MILPITAS SENIOR CENTER Repair and Restoration Project Phase 2 <i>Project 3268</i></p>	<p>GROSSMANN DESIGN GROUP ARCHITECTURE PLANNING RESEARCH 151 Townsend Street San Francisco, CA 94107 415-543-8618</p>
--	---


Phase 2
Project 3368

FLOOR PLAN

DRAWN	DATE 7/17/91
CHECK	JOB NO.

SHEET
A-2

A-4
5/24

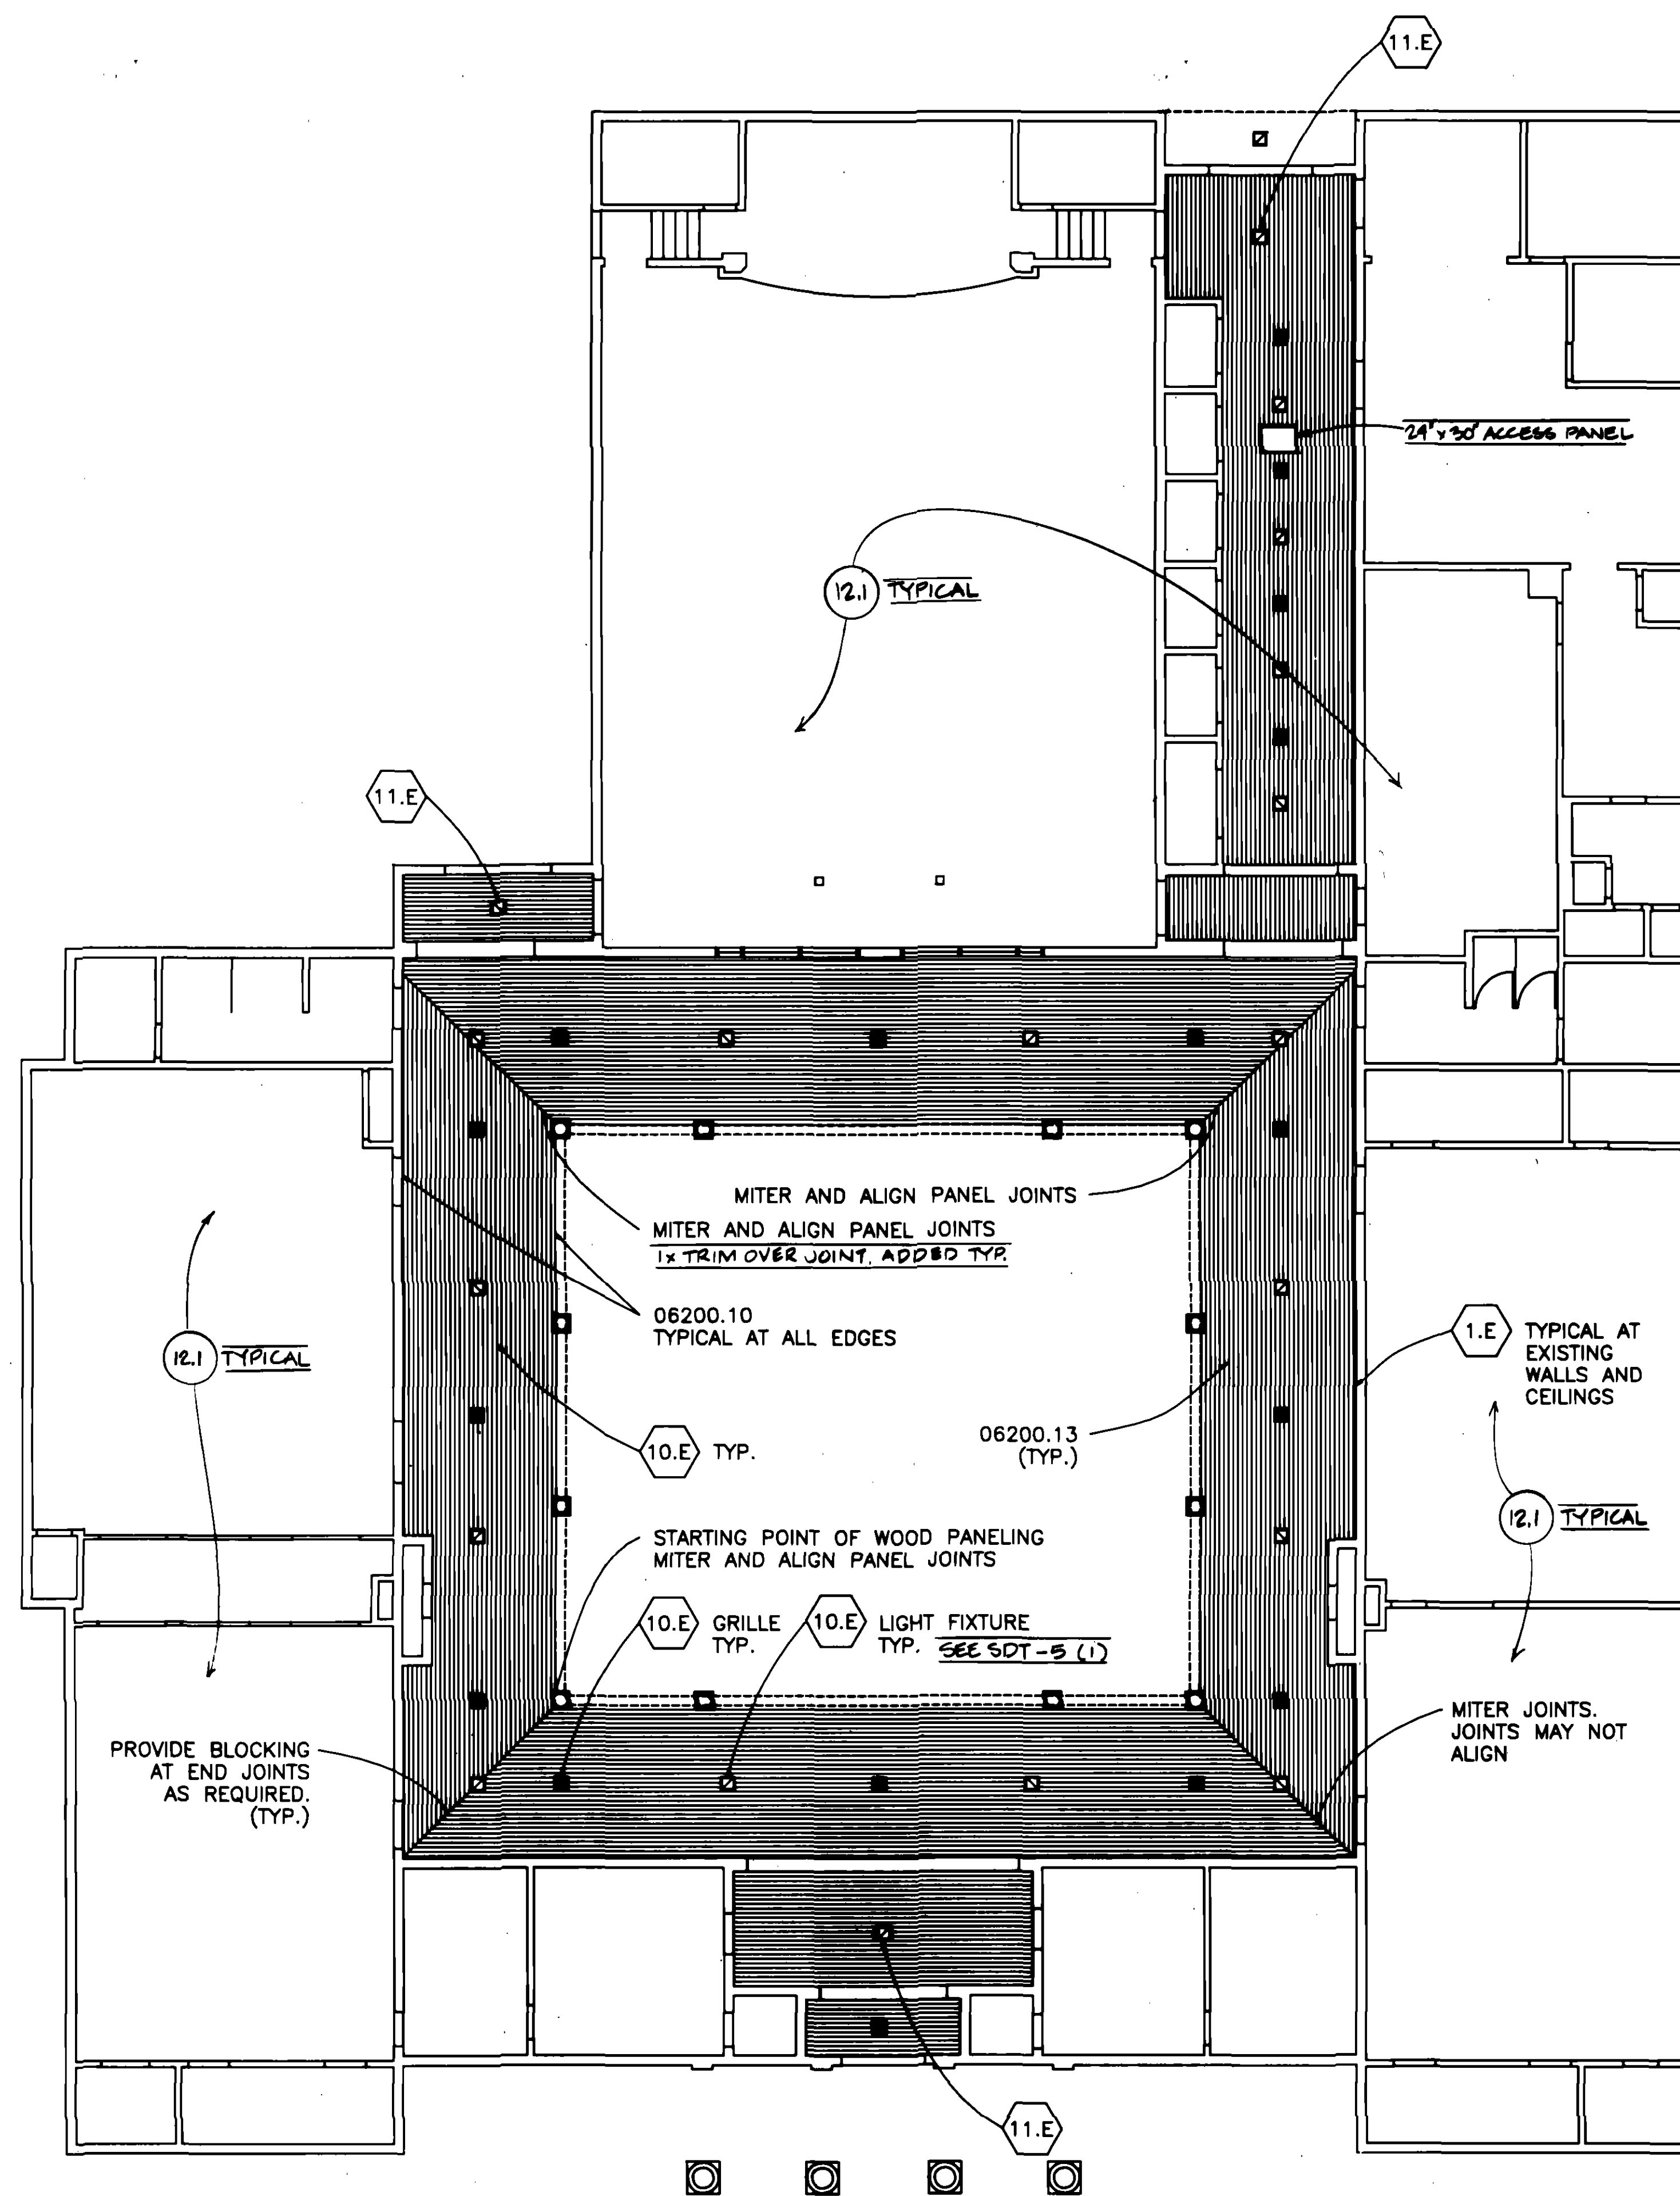

SCOPE AND NOTES, CEILING RENOVATIONS

See other Sheets for applicable notes.

RECORD DRAWING
4-1-83

GROSSMANN DESIGN GROUP
ARCHITECTURE PLANNING RESEARCH
151 Townsend Street
San Francisco, CA 94107
415-543-8618

**CITY OF MILPITAS
MILPITAS SENIOR CENTER
Repair and Restoration Project
Phase 2
Budget 3368**

[illegible]

A-4

2-913 - 1-5
6/24

2.E Remove existing cement plaster above existing projected wood mouldings to top of parapet at exterior north, east, south, and west walls as shown on the drawings. After installation of new roofing and flashings (see notes regarding roofing work) install new cement plaster finish. Install new parapet coping (cap flashing) as shown on the drawings. Paint cap flashing and all new cement plaster work. See specification Sections 02080 DEMOLITION, 07800 FLASHING AND SHEET METAL, 09220 CEMENT PLASTER and 09900 PAINTING

4.E. Remove existing glazing at existing auditorium window wall. Replace with 1/4" thick tempered glass. Provide new exterior and interior wood chair rail as shown on the drawings. Paint exterior and interior of existing auditorium window wall and new chair rails. See specification Sections 02060 DEMOLITION 06200 FINISH CARPENTRY, 08800 GLAZING, and 09900 PAINTING.

6.E Texture existing concrete paving one foot around existing drinking fountain near Room 110, Women's. Remove the existing drinking fountain and install a new drinking fountain meeting the requirements for access by the physically disabled. The new drinking fountain must be installed in accordance with the ADA and ADAAG and installed in accordance with the manufacturer's written recommendations. Fasten to existing wall construction securely and provide blocking as required by mounting brackets. Adjust existing plumbing as required to meet existing water and sewer connections as required. See specification Sections 09225 PORTLAND CEMENT PLASTER REPAIR and 09800 PAINTING.

8.E Remove existing soffits (including substrate wood paneling) and light fixtures at courtyard and exterior corridor at rear of building (Room 103). Protect existing conduit, junction boxes etc. serving existing light fixtures from damage.

9.E Remove existing cement plaster finish and substrate in existing skylight openings in soffit of Room 103, Corridor. Frame existing skylight openings in soffit of Room 103, Corridor, with 2 x 6 wood joists at 16 inches on center. Use joist hangers to attach new wood joists to existing wood wall framing or new rim joists. New wood framing shall be intended as support for new wood soffit. Adjust existing sprinkler system in existing skylight openings as needed to provide proper coverage. Obtain approval from the City of Milpitas Building Inspection Division for revised sprinkler layout. See specification Section 02080 DEMOLITION, and 06100 ROUGH CARPENTRY.

11.E Install new wood paneling at the soffit, ventilation grilles, and light fixtures in Room 103, Corridor, and at front entry as shown on the drawings. See Note 10.E.

12.E Remove existing wood columns at courtyard. After completion of structural work, install new wood columns to match profile and size of existing. Provide new watertight sheet metal cover flashings at top of new wood columns. Paint new wood columns and flashing. See specification Sections 02080 DEMOLITION, 06200 FINISH CARPENTRY, 07600 FLASHING AND SHEET METAL, and 09900 PAINTING.

14.E Remove existing cement plaster at roof side of parapet walls. Install new exterior finishes, and paint if required, as shown on the drawings. See notes regarding roofing work. See specification Sections 02060 DEMOLITION, 07311 ASPHALT SHINGLES, 09220 CEMENT PLASTER, and 09900 PAINTING.

15.5 ~~Remove~~ REPAIR existing decorative scrolls at top of existing exterior columns at front of building. ~~Remove decorative scrolls at top of exterior columns and replace the decorative scrolls with new scrolls to match the existing or to have the existing scrolls repaired by a specialty subcontractor. If the general contractor selects to have the existing decorative scrolls repaired, see the specifications for specific repair requirements. Reinstall steel-reinforced concrete decorative scrolls with new decorative scrolls with new watertight steel metal-over flashings.~~ Reinstall steel-reinforced concrete decorative scrolls with new decorative scrolls with new watertight steel metal-over flashings. See specification Sections 06200 FINISH CARPENTRY, and 07600 FLASHING AND SHEET METAL.

16.E Patch the existing columns at the front of the building as required to prepare for painting. Remove trim at square column bases, and repair and patch existing columns bases (See note 15.E). ~~Flash top of the square column bases with new watertight sheet metal cover flashings.~~ See specifications for specific repair requirements. See specification Sections 06200 FINISH CARPENTRY and 07600 FLASHING AND SHEET METAL.

17.E. ~~Remove~~ ^{REPAIR (IN PLACE)} existing decorative scrolls at top of existing plaster columns at front exterior wall of building. ~~The general contractor has the option of either replacing the decorative scrolls with new scrolls similar to the existing or to have the existing scrolls repaired by a specialty subcontractor.~~ If the general contractor selects to have the existing decorative scrolls repaired, see the specifications for specific repair requirements. See specification Sections 06200 FINISH CARPENTRY.

19.E Patch and repair existing decorative scrolls at side windows at front of building and fasten securely to existing building. See specification Sections 06200 FINISH CARPENTRY.

20.E Patch and prepare for painting all existing wood work at front of building including wood windows, mouldings, and decorative woodwork.

21.E Fabricate new wood planter boxes to match the existing at the front of the building. Fasten securely to building to match existing location. ~~The general contractor has the option of either replacing the existing planter boxes with new planter boxes similar to the existing or to have the existing planter boxes repaired by a specialty subcontractor. If the general contractor elects to have the existing planter boxes repaired, provide the specifications for specific repair requirements. All rotted or decaying wood shall be replaced, and all joints made tight. Provide new plywood covers for existing or new planter boxes. Provide new sheet metal flashings over the new plywood covers. Remove existing cement planter above the existing planter boxes and pour new concrete to match the existing planter above the existing cement planter as required. See specification Sections 06200 FINISH CARPENTRY, 07800 FLASHING AND SHEET METAL, and 09225 PORTLAND CEMENT REPAIR.~~ **REMOVE EXISTING & PROVIDE ALL NEW 1/2" X 6" HANDRAIL. SEE**

22.E Cut ends of existing pipe handrail and ramp at front of building. Add new galvanized steel pipe sections to extend return ends 12' beyond the end of the ramp. New sections shall be welded to existing pipe handrail and all welds shall be ground smooth. Weld a continuous 1/4" by 2" galvanized steel flat bar to inside of existing pipe handrail vertical supports. Top of new flat bar shall be 4" above existing grade of ramp. See specification Section 05500 METAL FABRICATIONS and 05520 HANDRAILS AND RAILINGS. 05490 PAINTING

23.E Prepare all existing exterior finishes (wood, cement plaster, and sheet metal) at front of building for painting. Paint entire front of building. See specification Section 09900 PAINTING.

24.E ~~But ends of existing pipe handrail at exterior exit stairs at the NW and SE corners of the Auditorium. Add new galvanized steel pipe sections to extend return ends as shown on the drawings. New sections shall be welded to existing pipe handrail and all welds shall be ground smooth. Paint handrails. See specification Sections 05500 METAL FABRICATIONS, 05520 HANDRAILS AND RAILINGS, and 09900 PAINTING.~~ SEE SDT-12. ALL NEW 1 1/2" O.D. RAIL

25.E Remove existing concrete stairs and landings at exit stairs at the NE corner of the Auditorium and at Room 109, Vestibule. install new concrete landings and handrails as shown on the drawings. Paint handrails. See specification Sections 02060 DEMOLITION, 03300 CAST-IN-PLACE CONCRETE, METAL FABRICATIONS, 05520 HANDRAILS AND RAILINGS, and 09900 PAINTING. 05500 SEE STD-12

28.E. Install new mechanical equipment screens around existing equipment installed on the north and south sides of the buildings as shown on the drawings. Remove existing wire mesh fencing and posts as required to accommodate new equipment screens. ~~Provide new wire mesh gate and posts to match existing as required by new mechanical equipment screens.~~ Paint all exposed surfaces. See specification Sections 02080 DEMOLITION, 04220 CONCRETE UNIT MASONRY, 06200 FINISH CARPENTRY, and 09900 PAINTING, and DIVISION 3.

27.E Remove existing abandoned electrical conduit at base of north and east exterior walls of the building. Seal and patch holes as required. See specification Section 02060 DEMOLITION.

29.E Install new circular redwood louvers with insect screens as shown on the drawings. Paint new louvers. See specification Section 06200 FINISH CARPENTRY and 09900 PAINTING.

30.E Install new site storm drainage system at perimeter of building as shown on the drawings. See sheets C-1 and C-2. See DIVISION 2 and DIVISION 3.

31.E Remove existing landscaping as required by work shown on sheets C-1 and C-2. Protect existing trees that remain from damage during construction, and adjust finished grades around entire perimeter of building as shown on sheets C-1 and C-2. See specification Section 02060 DEMOLITION AND REMOVAL.

32.E Existing service weatherheads and two service feeder conduits on top of the existing roof. Existing supports to be removed to facilitate installation of the new roof. Provide temporary supports as required. The conduits shall be permanently reinstalled on the new roof as shown on the drawings. Provide flashings as required. See specification Sections 07600 FLASHING AND SHEET METAL and DMSION 16.

33.E Electrical Work - General (applies to roof renovation work also):

a) All conduits in new construction shall be installed concealed, unless otherwise noted or existing conduit noted to be replaced is currently exposed. If new conduits, boxes, devices, etc. are to be installed on existing construction, exposed installation is allowed to match existing.

- b) Where existing outlets are shown to remain, the contractor shall provide extension collars as required. Install new conduit and wiring where needed to maintain continuity of existing circuits.
- c) The exact location of conduit stub-ups, outlet box locations, etc. for equipment shall be coordinated with equipment requirements.

34.E. Install a new 30" x 30" access panel in the existing wall. See specification Section 08305 ACCESS DOORS.

35.E Install new pipe handrail at front entry. See specification Section 05520 HANDRAILS AND RAILINGS. SEE SOT-12

38.E Paint 2" wide contrasting strip at nosing of upper landing and each stair step where indicated on Drawings. Repaint strips where existing. Strip shall not be more than 1" from nose. See specification Section 09900 PAINTING. Paint shall comply with City of Milpitas and CAC (Title 24) requirements for stairway marking.

37.E Remove existing door and provide new door and hardware at west Auditorium entrance as follows:

Door: Glazed, wood rail and stile door similar to existing with 12" high bottom rail and 7" high intermediate rail as shown on Drawings. All glass shall be tempered. Door shall also be to AIA Standard 1400, Stile and Rail Doors, Premium Grade. Prime and Paint door to match existing with exterior side enamel, 1 coat primer and 2 finish coats minimum.

Exit Device: Von Duprin Series 88L with lever and key lock. Mount top of touch bar level with top of intermediate rail.

Cylinder: Match existing and keyed to existing system as directed by Owner.

Closer: LCN Delayed Action, 4041 "Super Smoothies".

Handles: 1 1/2 psi pull, existing steel, full mortise, concealed bearing type, 4 1/2 x 4 1/2.

Hardware: BSW or equal, 10" high each side.


Hardware Finish: Match existing finish on adjacent doors.

Threshold: Fill hole in existing wood threshold, prime and paint to match existing with epoxy modified acrylic latex floor paint, 2 coats minimum.

SEE

See specifications Sections 08200 FINISH CARPENTRY, 08800 GLAZING, 09900 PAINTING and DIVISION 1.

30.E Provide new closers at existing pair of doors, LCN Delayed Action, 4041 "Super Smoother". See specifications Sections 06200 FINISH CARPENTRY and DIVISION 1.

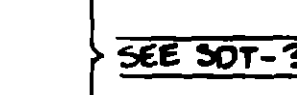

<p>CITY OF MILPITAS MILPITAS SENIOR CENTER Repair and Restoration Project Phase 2 Project 3368</p>	<p>GROSSMANN DESIGN GROUP ARCHITECTURE PLANNING RESEARCH 151 Townsend Street San Francisco, CA 94107 415-543-8618</p>	<p>RECORD DRAWING 4-1-83</p>
---	---	---

DRAWN PO		DATE 7/17/91	
CHECK JG	JOB NO. 0620.010		
SHEET		DATE	ACTION
	2/4/92	REVISION #1, ADDENDUM #1	AS/JG
	12/1/91	issued for bid w/	
	10/17/91	2.04g Price less Retain	JG
	7/17/91	ISSUED FOR CLIENT APPROVAL	JG
		CHECKED	
EXTERIOR ELEVATIONS - WEST			



RECORD DRAWING
4-1-93

GROSSMANN DESIGN GROUP
ARCHITECTURE PLANNING RESEARCH
151 Townsend Street
San Francisco, CA 94107
415-543-8618







**CITY OF MILPITAS
MILPITAS SENIOR CENTER
Repair and Restoration Project
Phase 2
Project 3368**

CHECK	DRAWN				
60	PG				
		2/4/72	REVISION #1, ADDENDUM #1		AS/JC
		12/4/70	issued for bid		
		10/17/71	Set for New District		J.G
		7/17/71	ISSUED FOR CLIENT APPROVAL		J.G
	DATE		ACTION		CHECKED
		7/17/71			
	JOB NO.				
		0620.010			

A-6

A-7
8/24

2-913

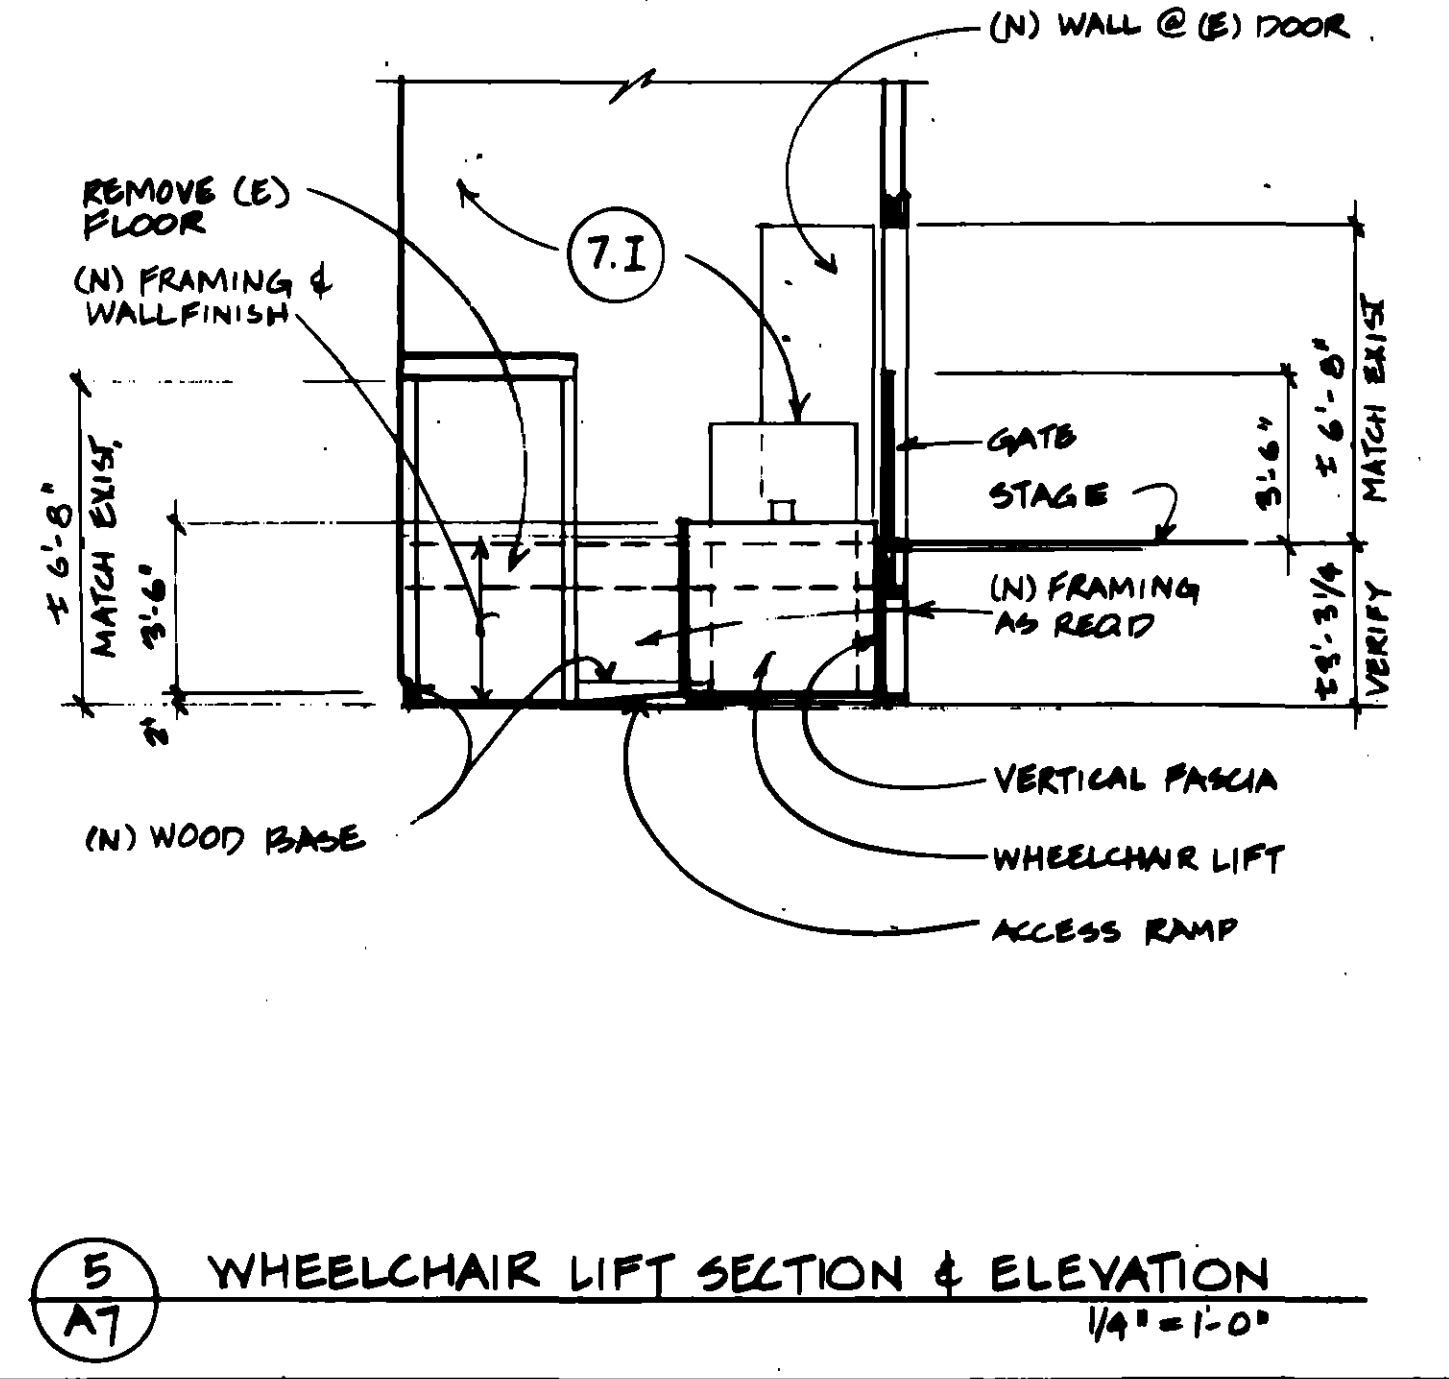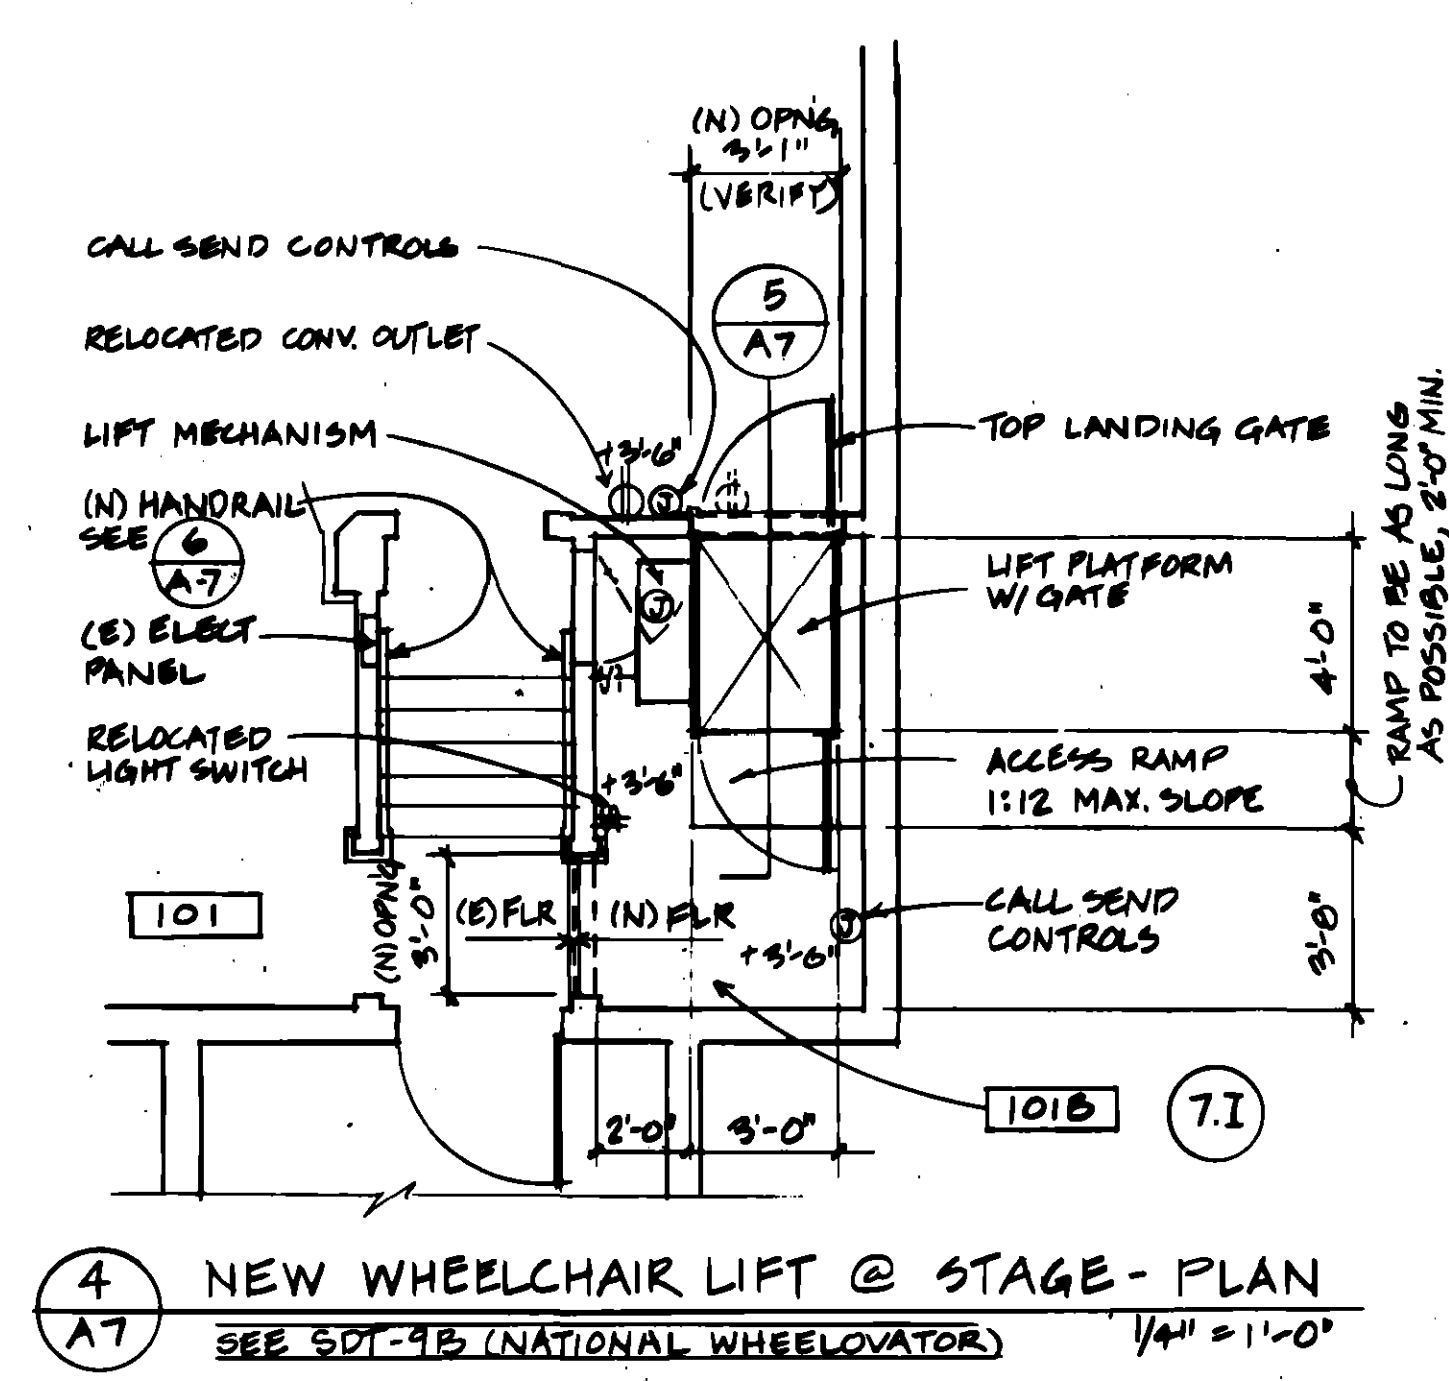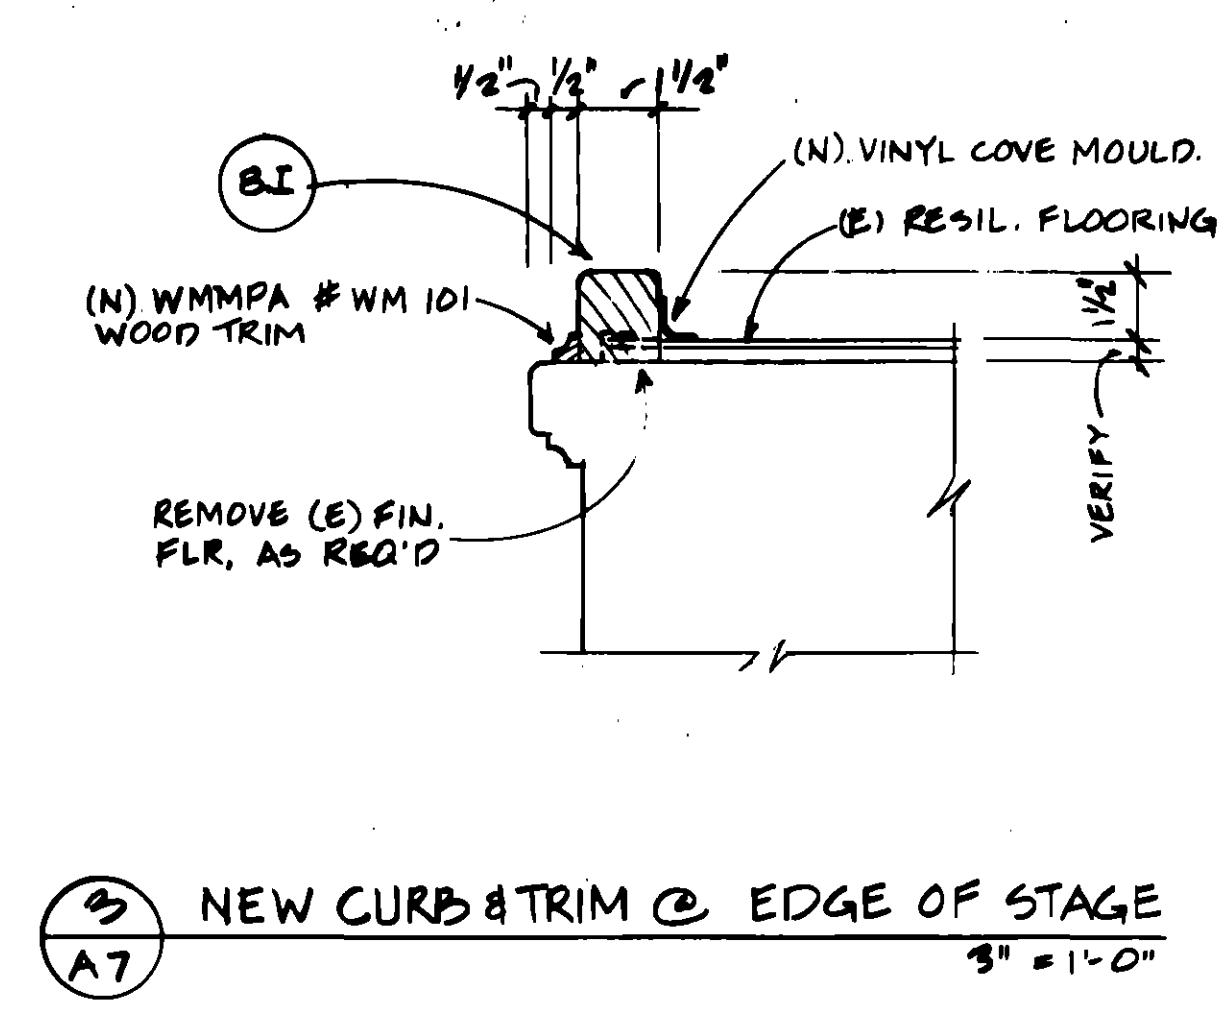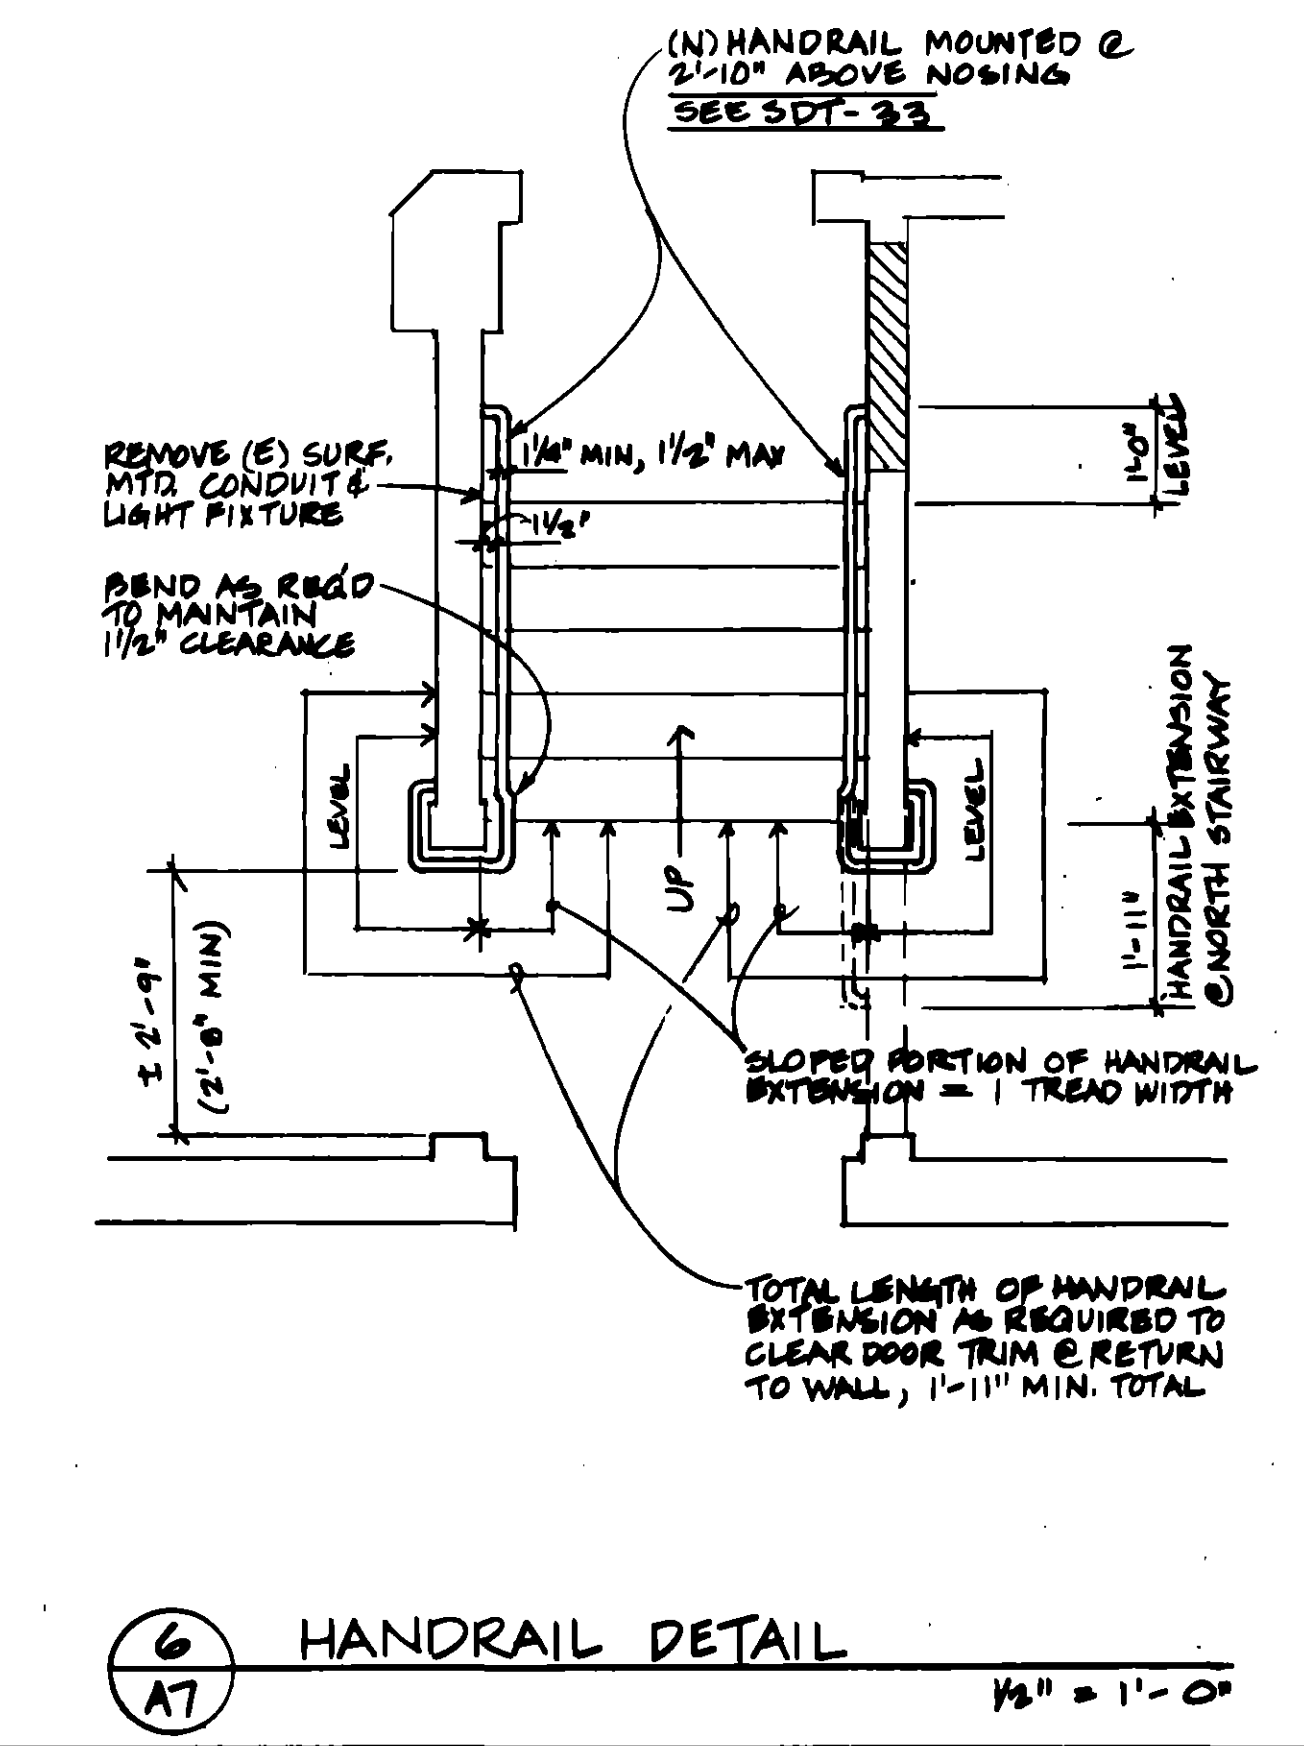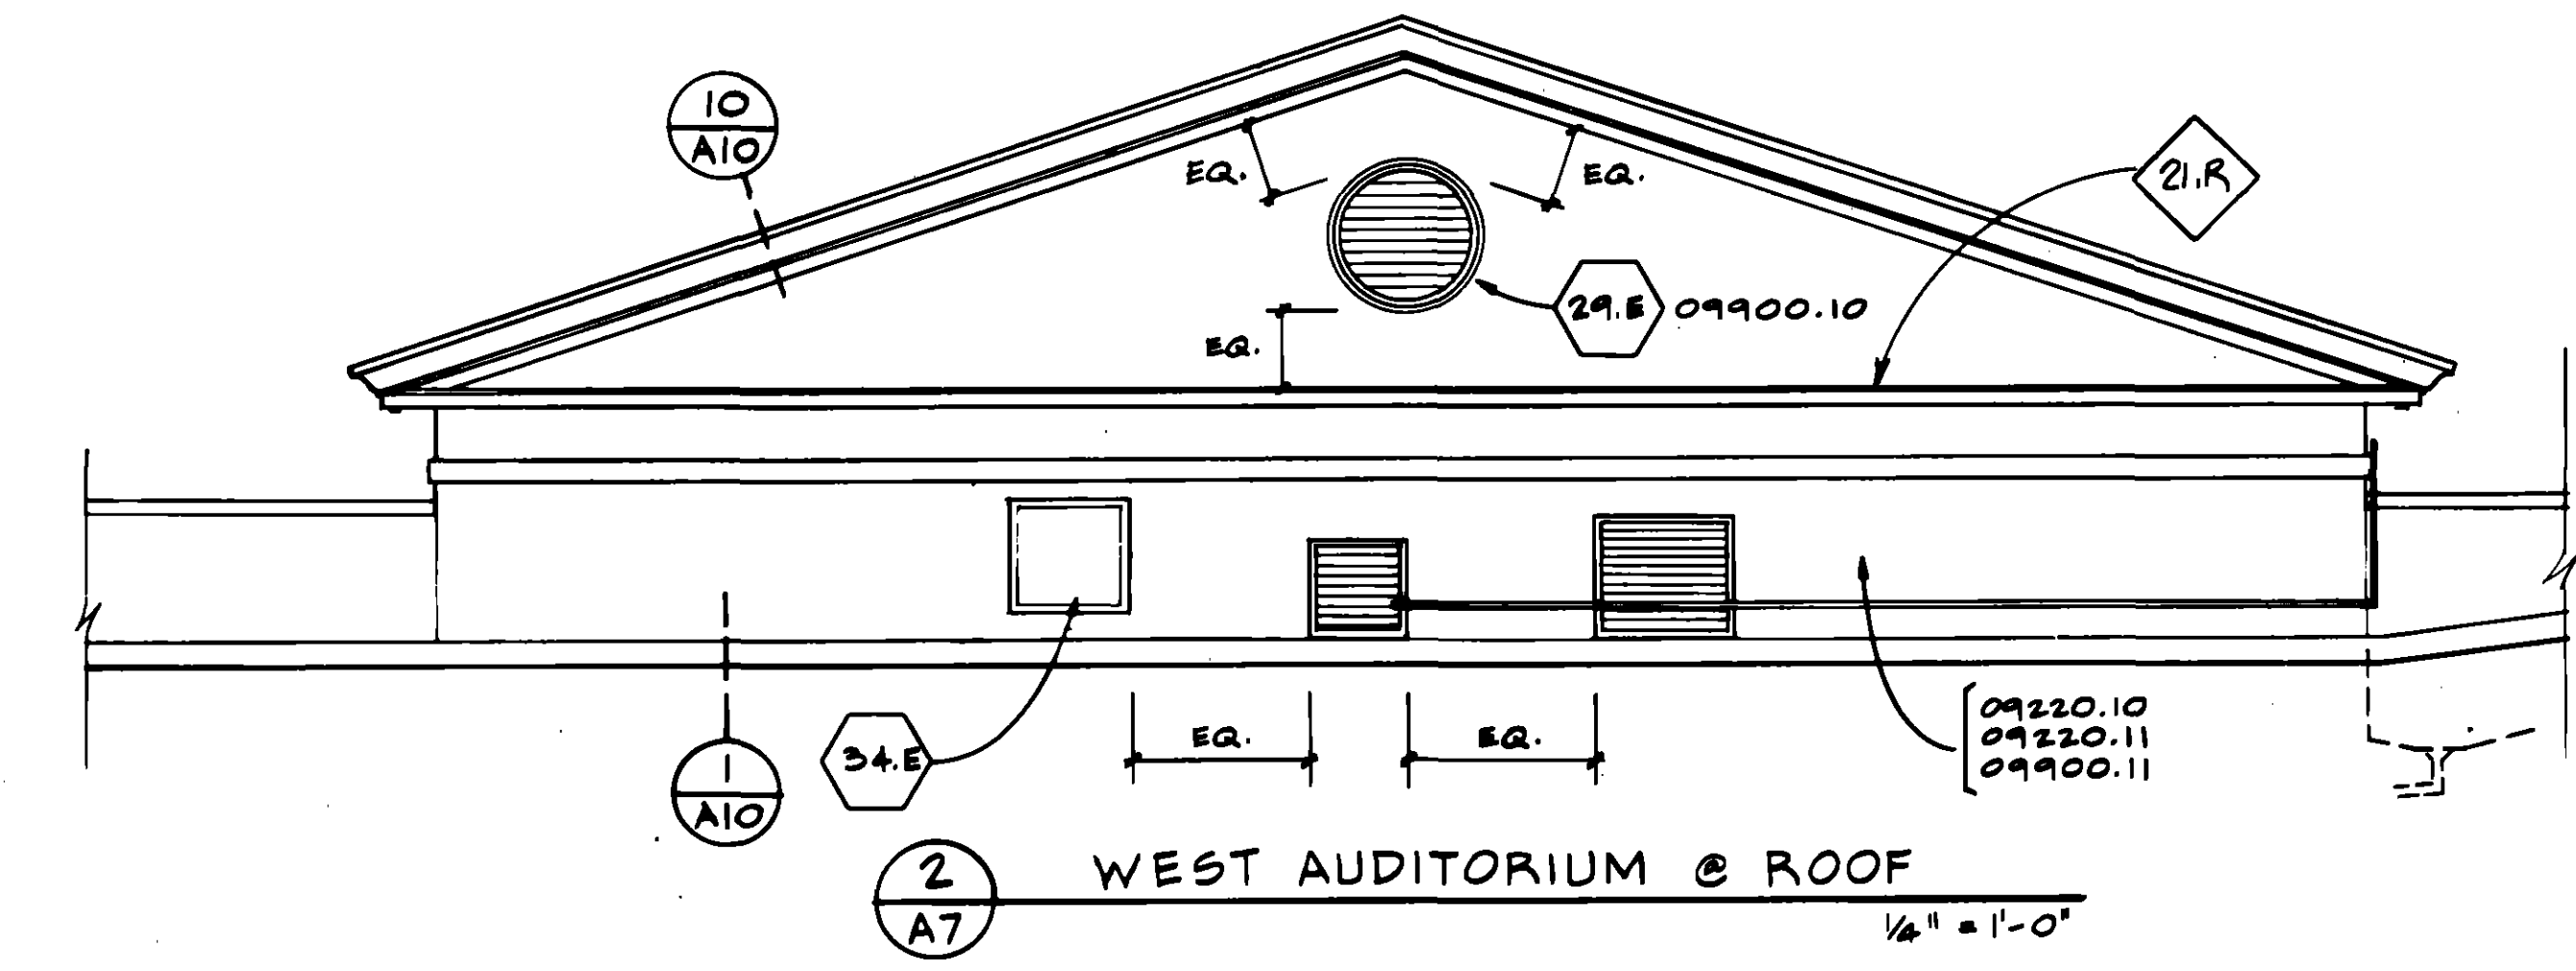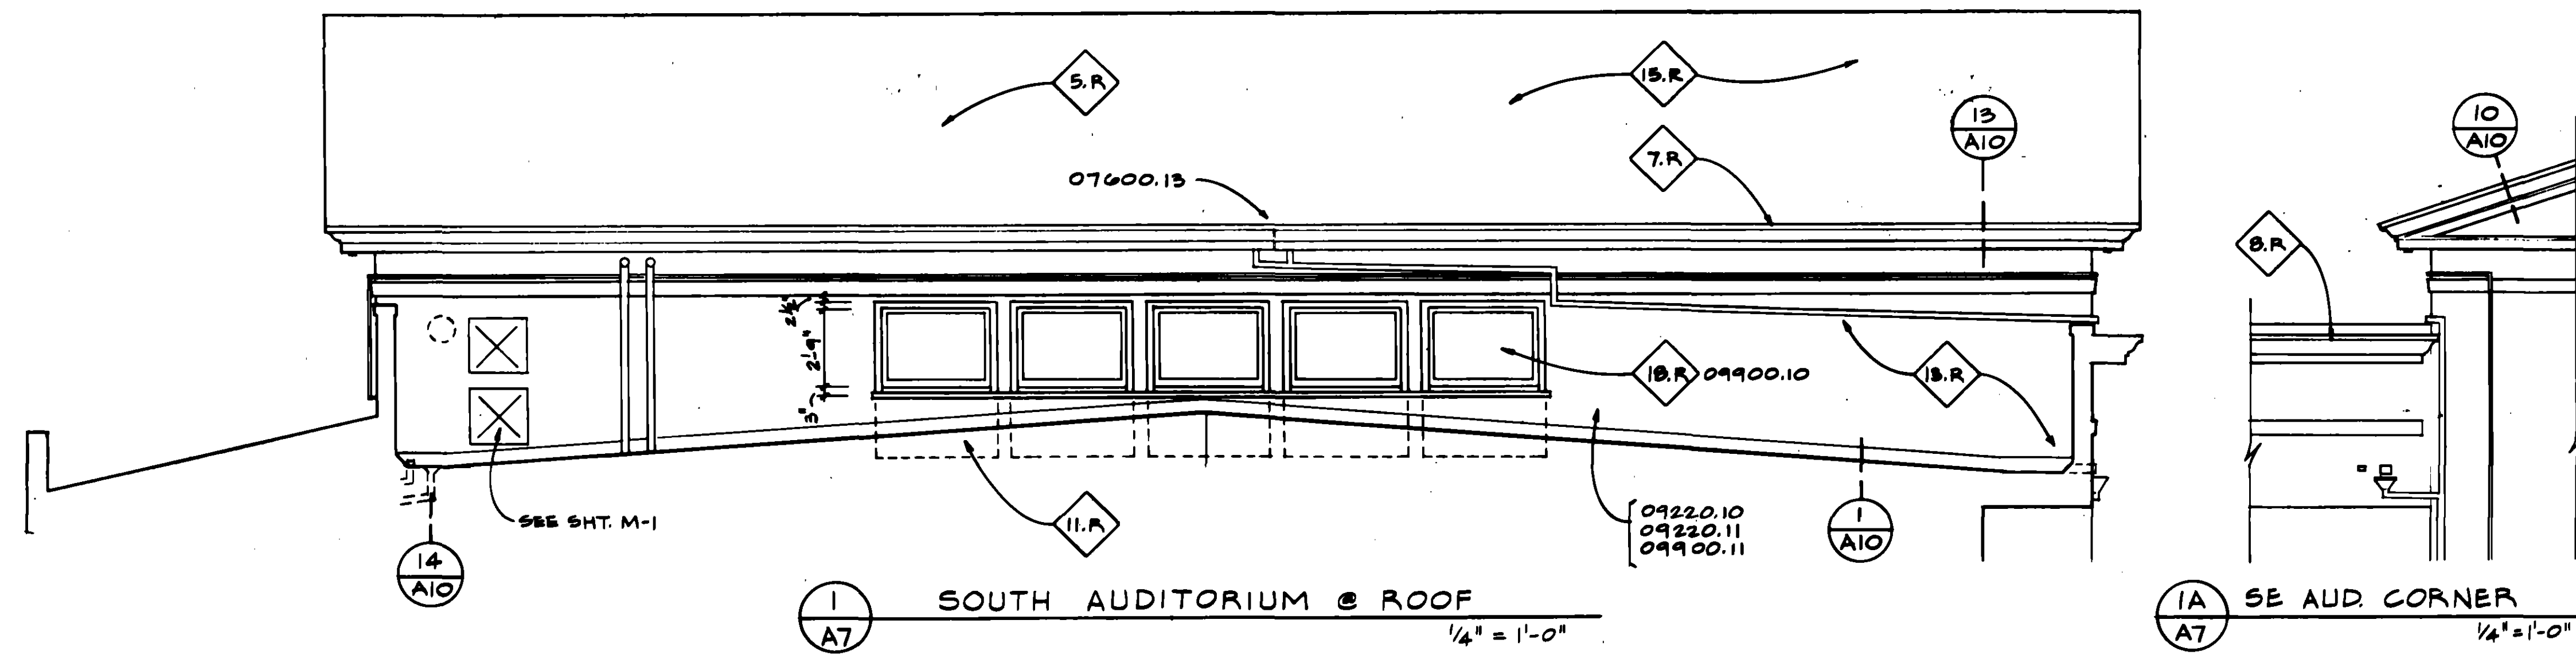

RECORD DRAWING
4-1-83

GROSSMANN DESIGN GROUP
ARCHITECTURE PLANNING RESEARCH
151 Townsend Street
San Francisco, CA 94107
415-543-8618


CITY OF MILPITAS
MILPITAS SENIOR CENTER
Repair and Restoration Project
Phase 2
Project 3368

3/5/92	2/14/92	12/14/91	10/1/91	7/17/91	DATE	ACTION	CHECKED
ATJ/JG	ATJ/JG	ATJ/JG	J.C.	J.G.			
REVISION #1	REVISION #2	REVISION #3	REVISION #4	REVISION #5			
2/14/92	2/14/92	12/14/91	10/1/91	7/17/91			
ATJ/JG	ATJ/JG	ATJ/JG	ATJ/JG	ATJ/JG			
2/14/92	2/14/92	12/14/91	10/1/91	7/17/91			
ATJ/JG	ATJ/JG	ATJ/JG	ATJ/JG	ATJ/JG			

DRAWN
PG
DATE
7/17/91

CHECK
JG
JOB NO.
0620.010

SHEET
A-7

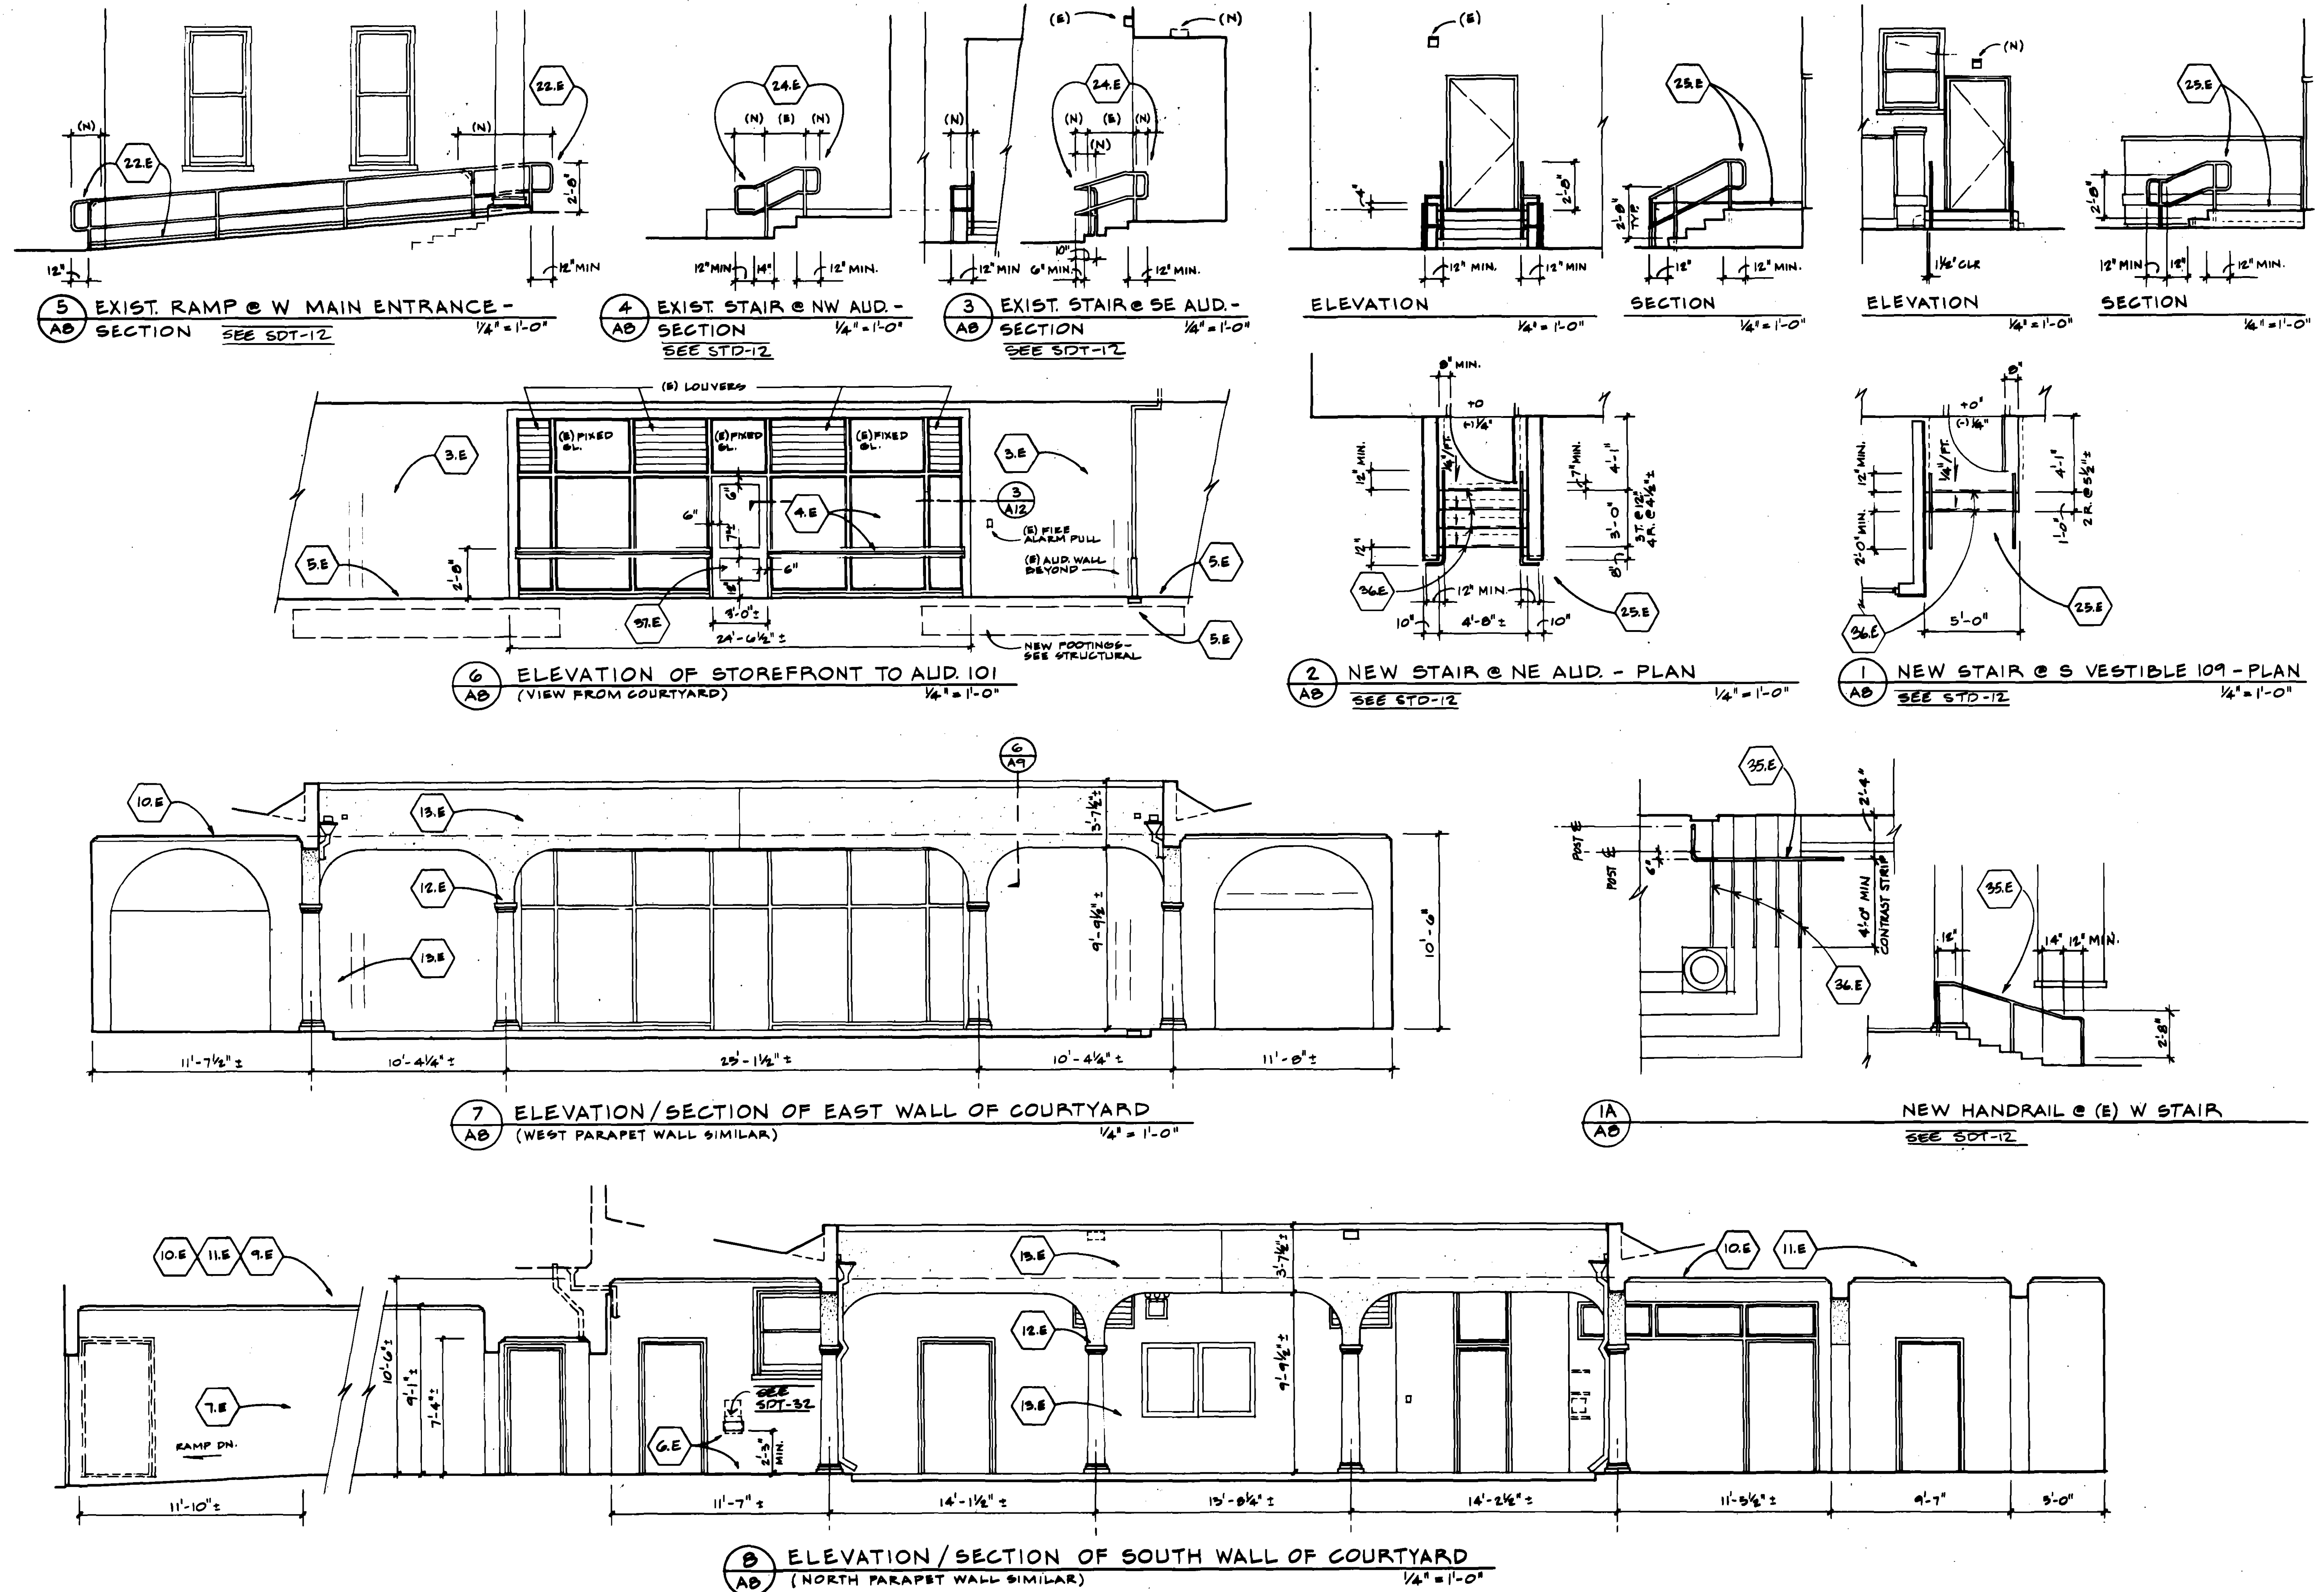

RECORD DRAWING
4-1-83

GROSSMANN DESIGN GROUP
ARCHITECTURE PLANNING RESEARCH
151 Townsend Street
San Francisco, CA 94107
415-543-8618




CITY OF MILPITAS
MILPITAS SENIOR CENTER
Repair and Restoration Project
Phase 2
Project 3360

DATE	ACTION	CHECKED
2/14/92	REVISION #1, ADDENDUM #1	AS/UA
12/14/91	ISSUED FOR CLIENT APPROVAL	JG
7/17/91	ISSUED FOR CLIENT APPROVAL	JG

EXTERIOR ELEVATIONS AND PLANS
CL. YD., EXT. STAIRS AND RAMPS

A-8

2-9/3

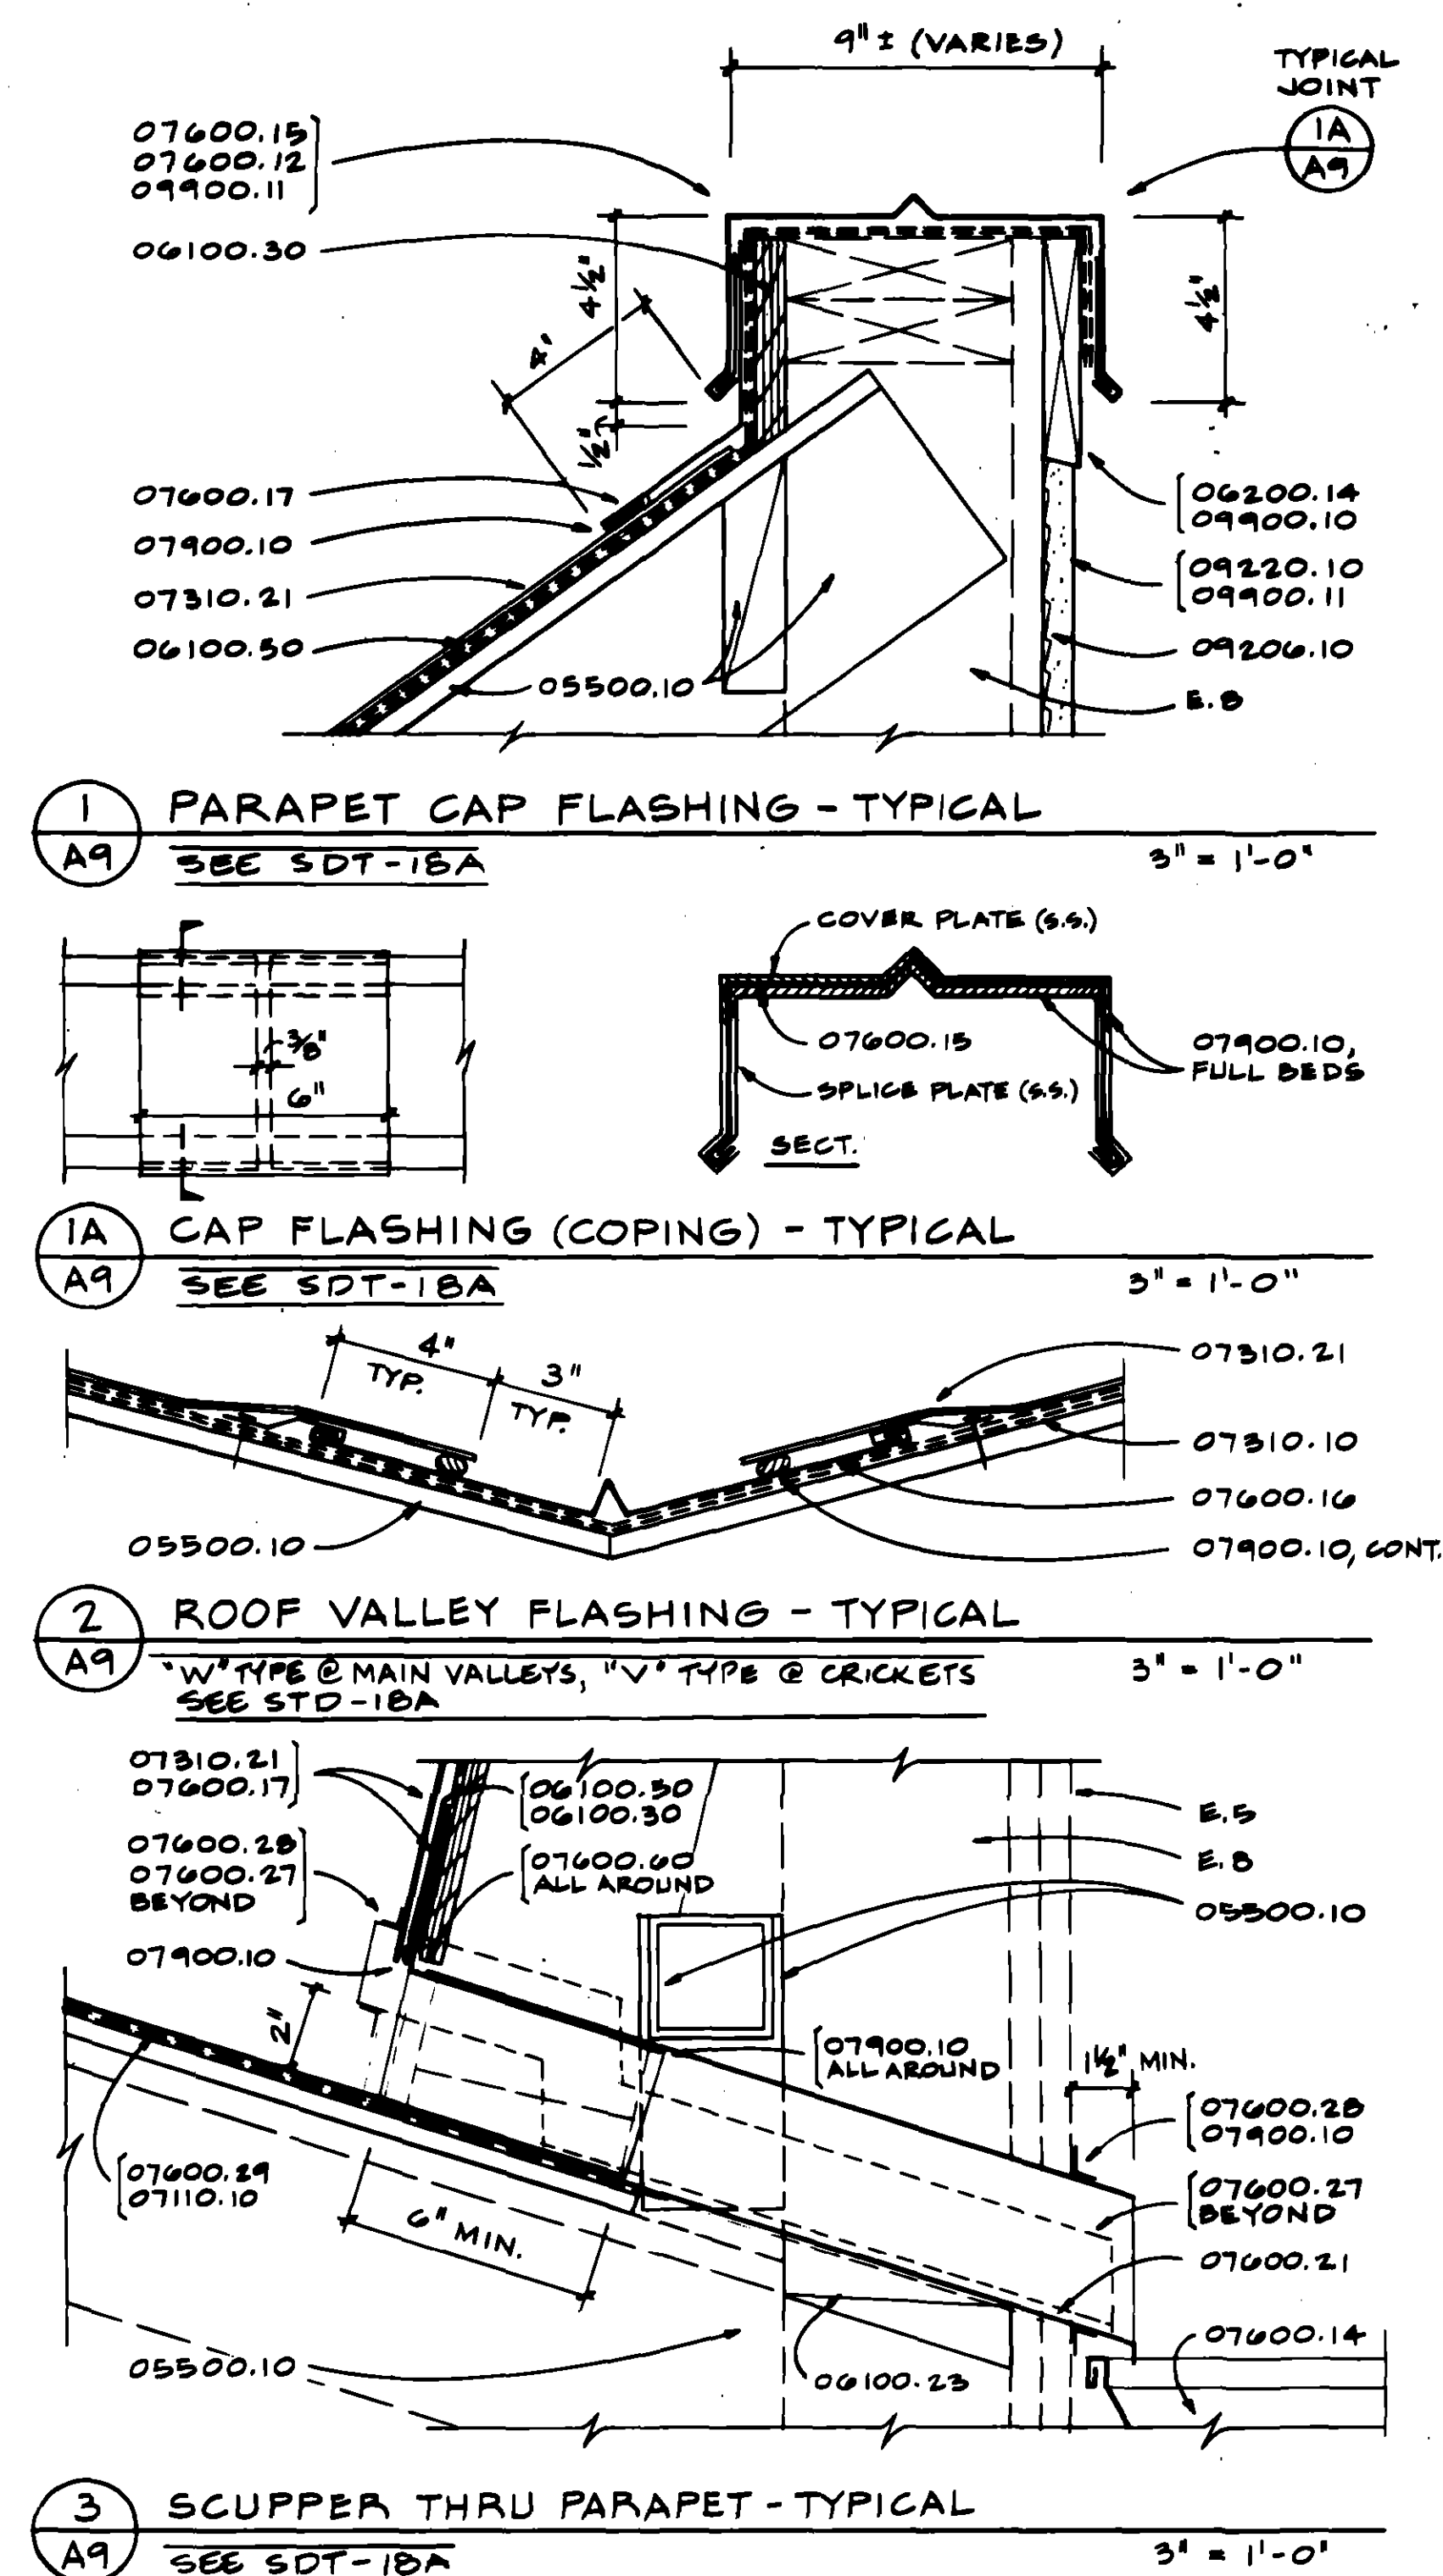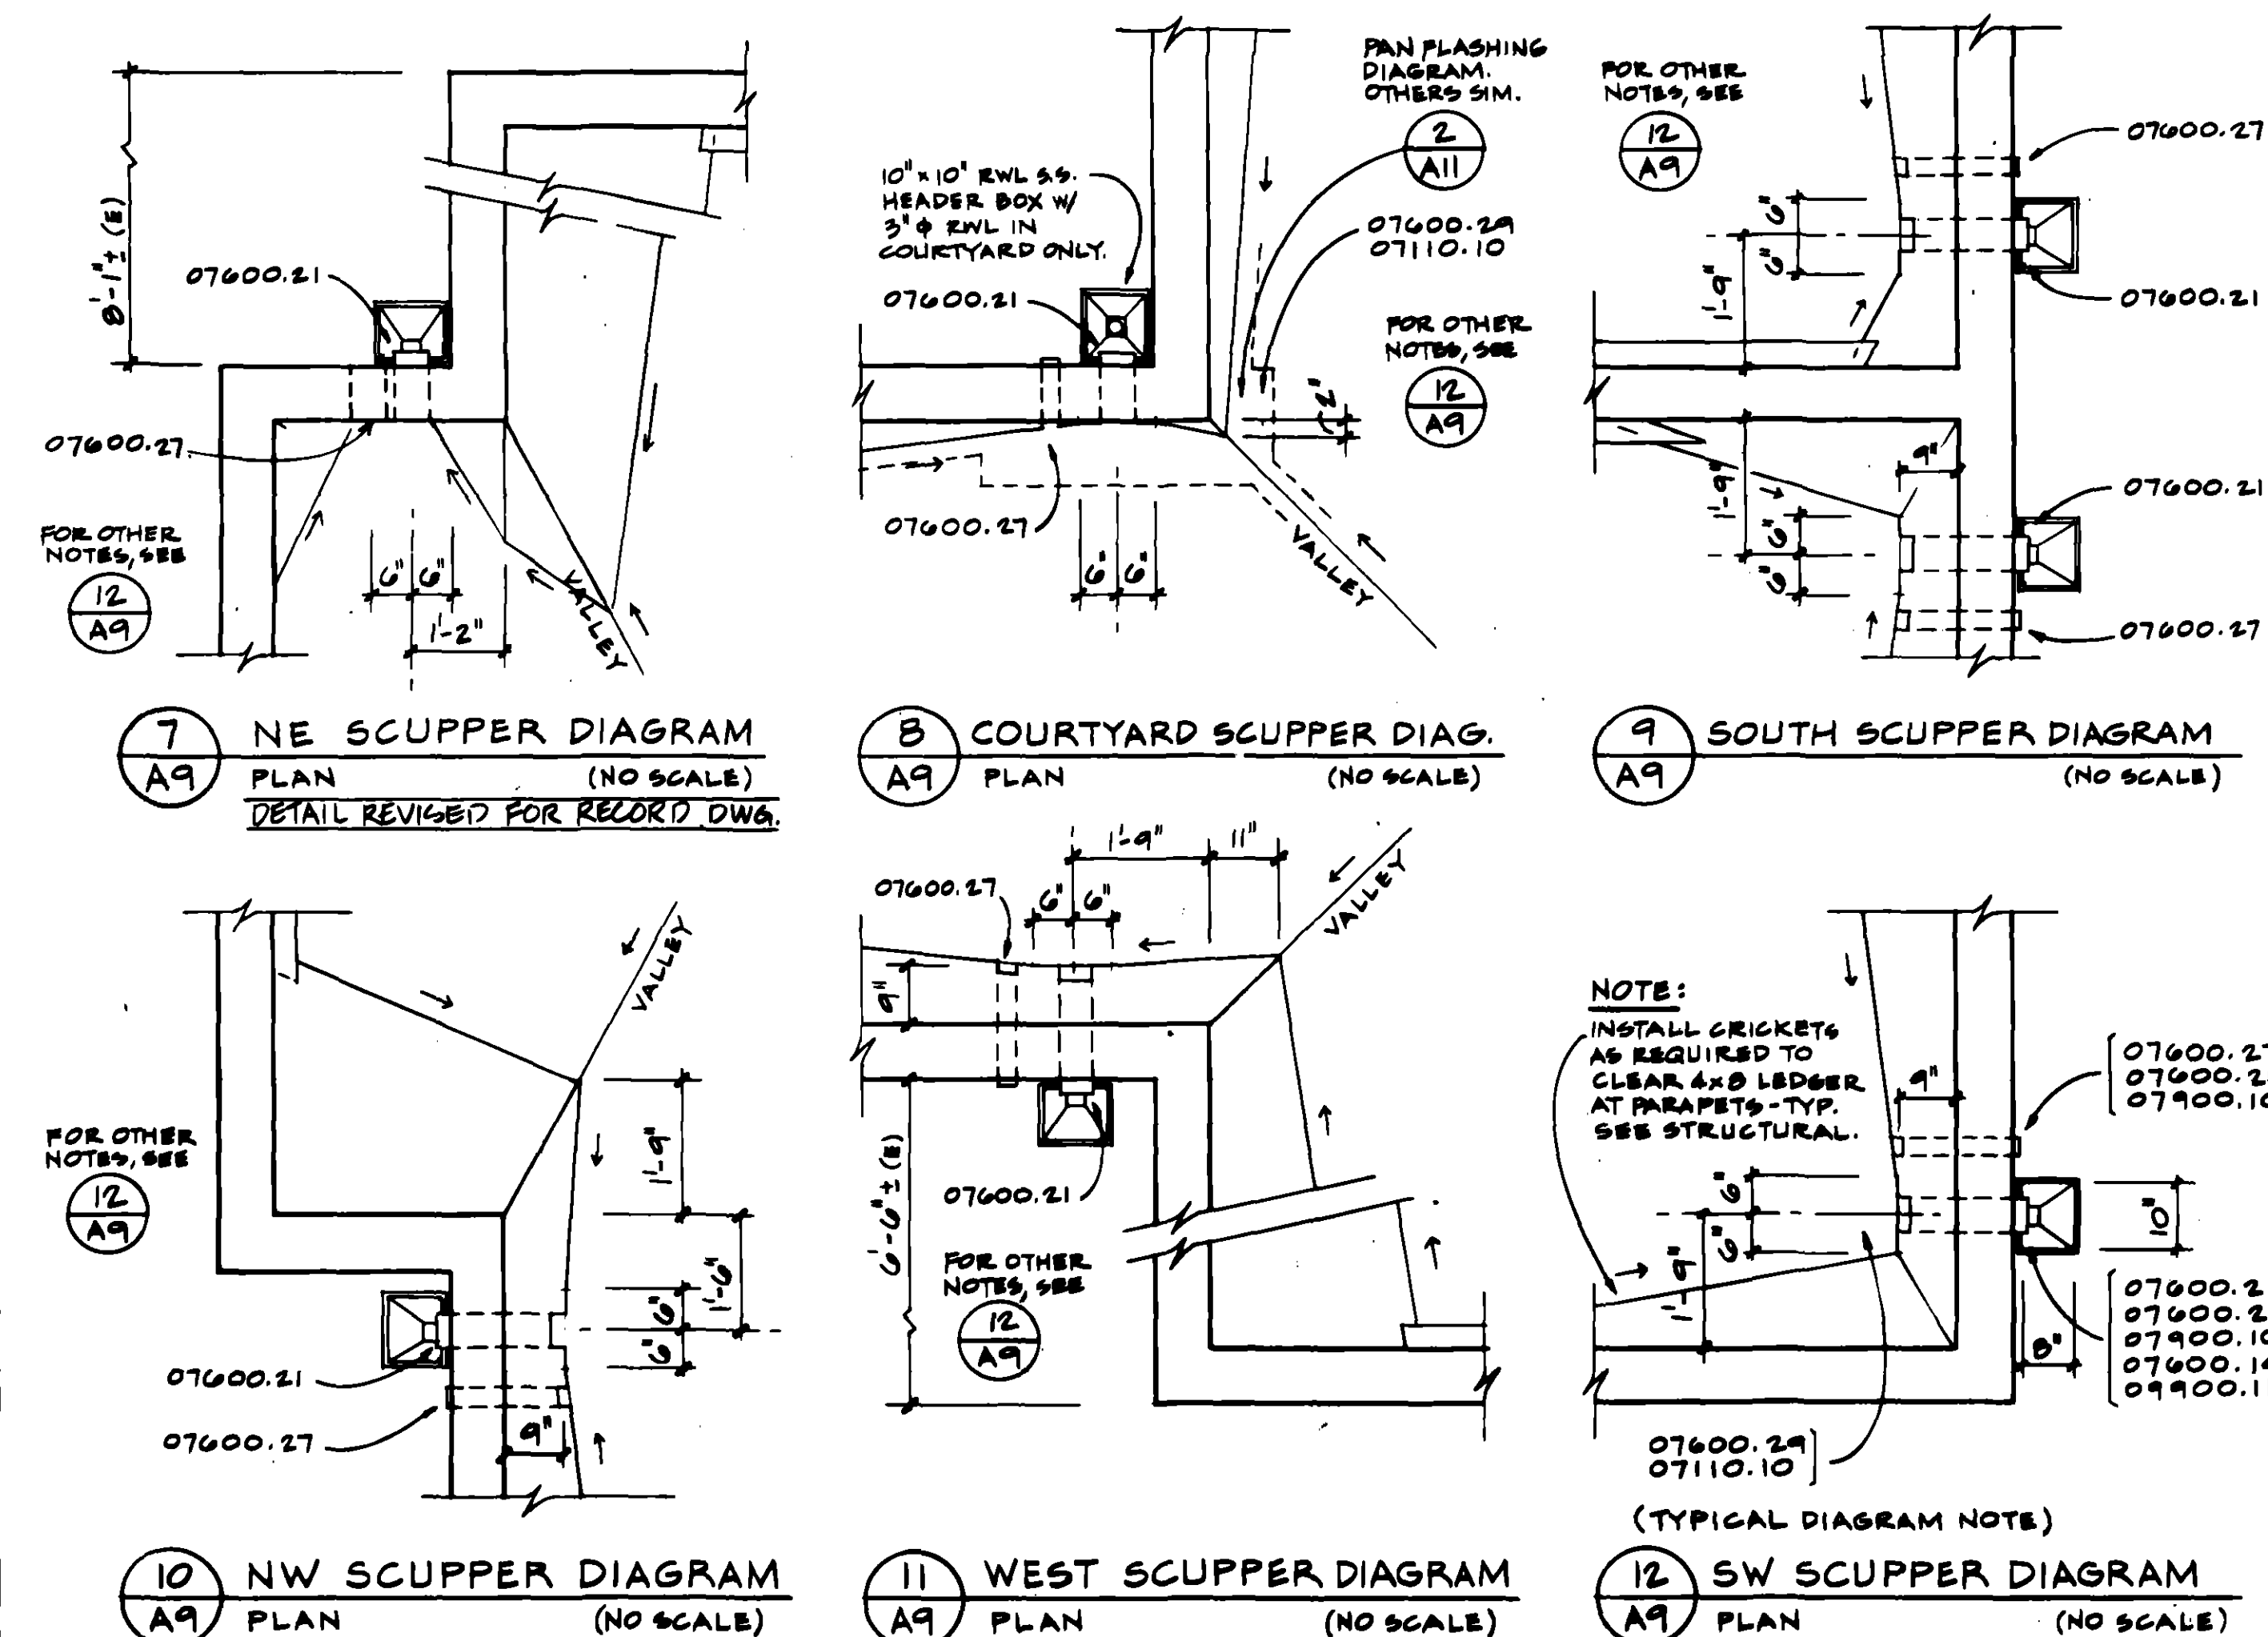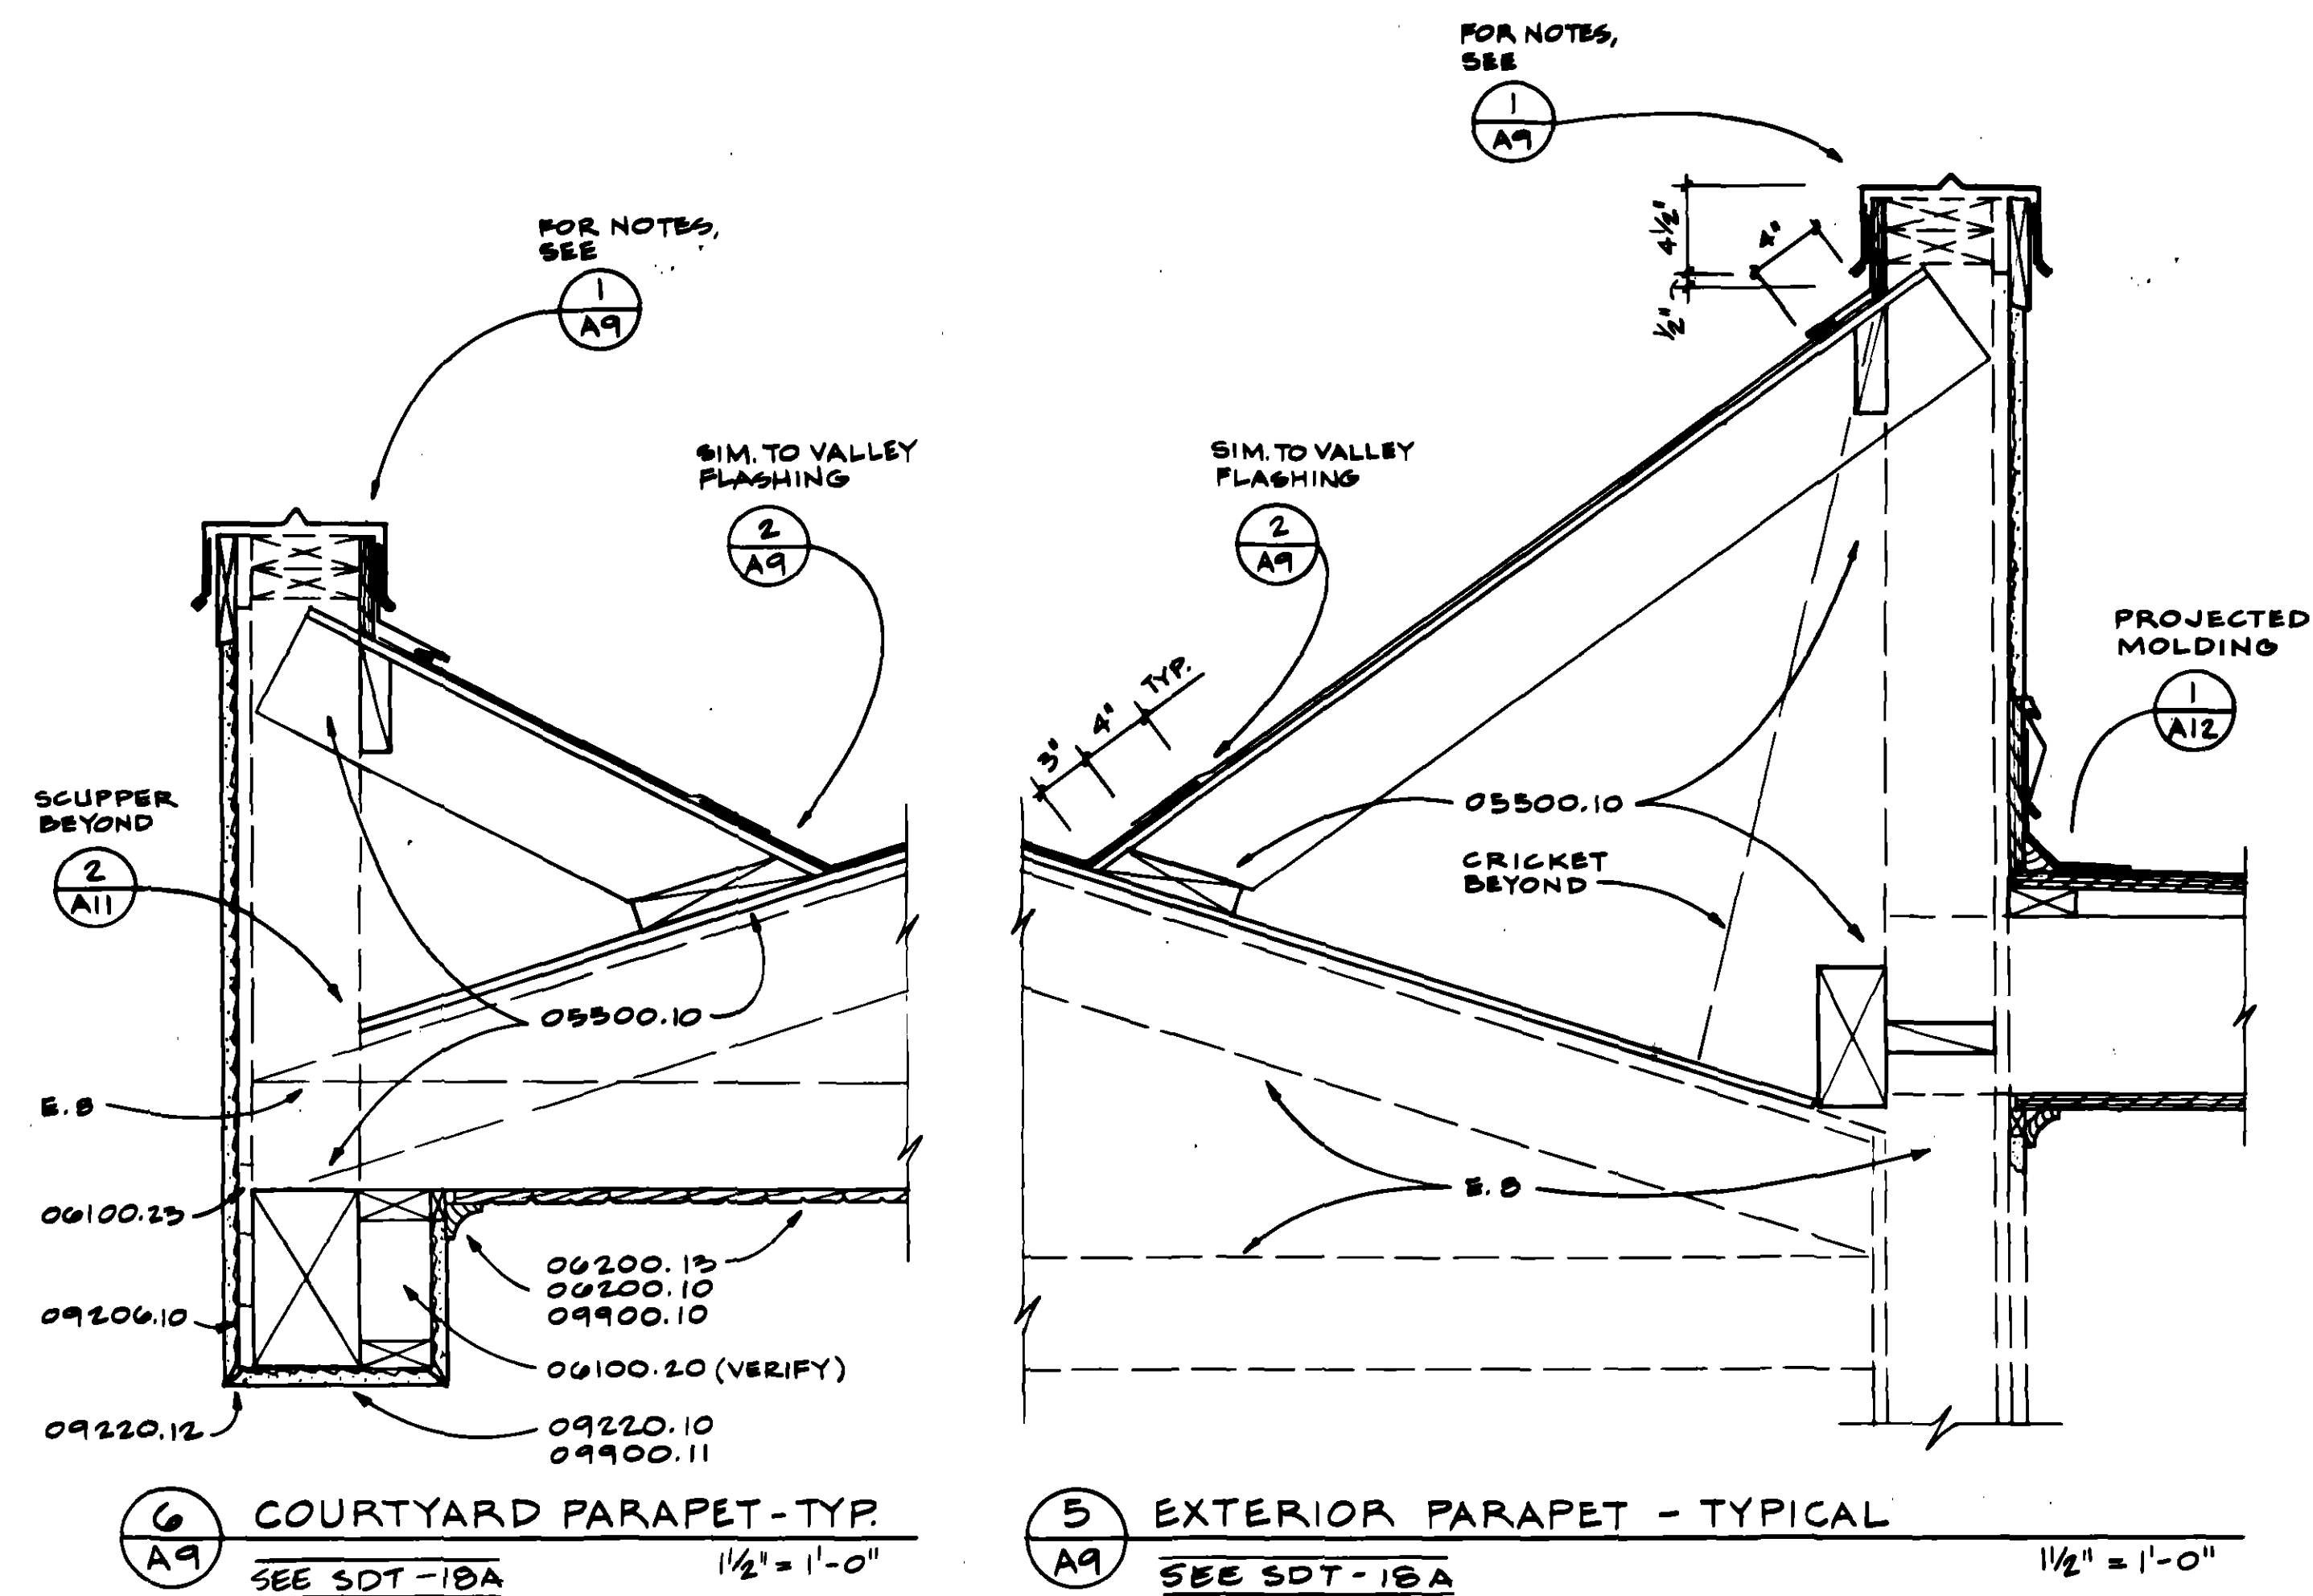

NOTES REGARDING DETAILS

- | | |
|----------|--|
| 03300.10 | New concrete stairs, landings, and handrails. See building elevations and detailed plans. Construction shall be accordance with "Standard Plans for Public Works Construction", by the American Public Works Association - Southern California Chapter, 1989 Edition, Standard Plan 640-0. Handrails shall be in accordance with Section 05520 of the specifications. Provide 1/2 inch chamfers at all exterior corners. |
| 04340.10 | 6 inch reinforced concrete unit masonry: See California Masonry Association of California and Nevada, Typical Details for Concrete Masonry - Typical Concrete Masonry Fence Design 6" Block. Provide stepped concrete footings as required by adjacent finished grades. Provide dampproofing (asphaltic emulsion) as required where top of footing is below adjacent grade. |
| 05500.10 | See structural drawings. |
| 05500.11 | Stainless steel Z-bracket, 1/8 inch thick. Install using stainless steel, countersunk screws. Pre-drill holes to avoid splitting wood. |
| 05500.12 | Galvanized steel angle brackets, 1/8 inch thick. Install using stainless steel, countersunk screws. Pre-drill holes to avoid splitting wood. |
| 05500.13 | Galvanized steel angle brackets, 2 1/2" x 2 1/2" x 1/4". Weld angle support plate and upper triangular fin to 1/4" thick galvanized steel plates. Bolt plates to new 2 x 6 blocking with 3/8" stainless steel lag bolts and lock washers. Secure upper diagonal with 3/8" stainless steel lag bolts and lock washers. |
| 05500.14 | Galvanized steel angle legs and cross-bar, 2 1/2" x 2 1/2" x 1/4". Weld legs (variable lengths) to 1/4" thick galvanized steel plates and bolt assembly together with 3/8" stainless steel lag bolts and lock washers. |
| 05500.15 | Galvanized steel bent plate or strap, 16 g. min. Attach to 2 x 4 wood plates with stainless steel screws. Do not penetrate roofing. |
| 05500.16 | Fasten existing conduits to angle supports with stainless steel straps, 16 g. min. and stainless steel screws as required. |
| 06100.10 | 3/8" galvanized bent rod, nut, and lock washer. Anchor shaped wood pieces at 2'-0" on center maximum. Locate anchors 1'-0" from corners. |
| 06100.20 | 2 x 4 wood framing. |
| 06100.21 | Shaped 2 x wood framing. |
| 06100.22 | 2 x 4 flat. |
| 06100.23 | New wood blocking as required. |
| 06100.24 | Wood cant. |
| 06100.26 | 2 x 6 wood framing. |
| 06100.28 | 2 x 8 wood framing. |
| 06100.29 | 2 x 10 wood framing. |
| 06100.30 | Plywood sheathing (exterior grade, 3/4 inch thick unless otherwise noted). See structural drawings as applicable. |
| 06100.40 | Framing connector. |
| 06100.50 | Building paper. |
| 06100.90 | Existing or new wood filler or blocking as required by field conditions. Replace deteriorated existing wood framing, blocking, and fillers. |
| 06200.10 | Western Moulding & Millwork Producers Association WM 85. |
| 06200.11 | Western Moulding & Millwork Producers Association WM 346. |
| 06200.12 | Western Moulding & Millwork Producers Association and WM 224. Attach with exterior grade adhesive and concealed stainless steel nails. Miter corners. |
| 06200.13 | Western Moulding & Millwork Producers Association and PT 37, 7 x 4. |
| 06200.14 | New wood moulding to match existing as required. |
| 06200.15 | Wood trim, surface applied. Miter and ease corners. |
| 06200.20 | Continuous redwood shaped board from 3 x 8. Return at gates. Miter corners. |
| 06200.21 | 3 x 4 redwood board both sides of opening. Anchor to concrete unit masonry with expansion anchors at 16 inches on center. |
| 06200.22 | 2 x 4 redwood frame with 2 x 4 diagonal redwood bracing at back. |
| 06200.23 | 2 x 2 redwood trim. |
| 06200.24 | 3/4 inch thick exterior grade plywood (for painted finish). |
| 06200.40 | Patch and repair existing wood moulding. |
| 06200.50 | Hardware for gates. |
| 06200.60 | Hardwood railing (birch or dense vertical grain douglas fir) shaped from 2 x 8 with rounded edges and mitered corners. Drill for concealed hardwood dowels (2 minimum at each corner) and securely glued at each mitered corner. |
| 07110.10 | Type 3 Roofing/Waterproofing (Elastomeric strip flashing). SEE SOT |
| 07110.11 | Elastomeric pads (neoprene) under plates. Provide neoprene washers (waterproof) at exposed bolt heads. SEE SOT |
| 07110.12 | Neoprene pad at each support. |
| 07310.10 | Protective underlayment. |
| 07310.11 | Continuous mastic or roofing cement under 2 x 4 wood plates held over shingles. |
| 07310.20 | Type 1A Roofing/Waterproofing (Asphalt Shingles). SEE SOT-13/5 |
| 07310.21 | Type 1B Roofing/Waterproofing (Asphalt Shingles). SEE SOT-13/6 |
| 07530.10 | Type 2 Roofing/Waterproofing (EPDM). SEE SOT-15C |
| 07800.10 | 22 gauge minimum stainless steel hanging gutter. SEE SOT-1 |

RECORD DRAWING
4-1-83

**GROSSMANN DESIGN GROUP
ARCHITECTURE PLANNING RESEARCH**

151 Townsend Street
San Francisco, CA 94107
415-543-8618

CITY OF MILPITAS
MILPITAS SENIOR CENTER
Repair and Restoration Project

**Repair and Restoration Project
Phase 2
Project 3368**










Page 7
Project 3368

ROOF DETAILS SCUPPER PLAN DIAGRAMS

DRAWN PG	DATE 7/17/91
CHECK JS	JOB NO. 0620.010
SHEET	

A-9

2-9/13

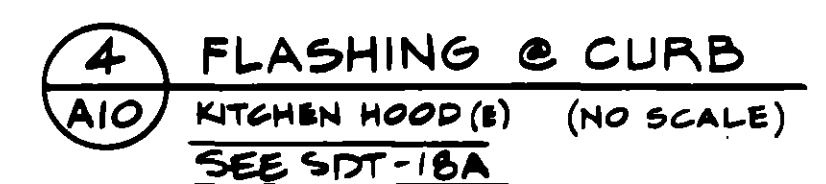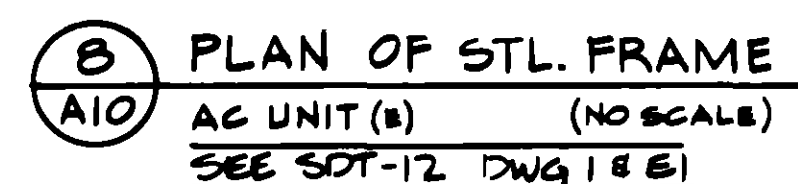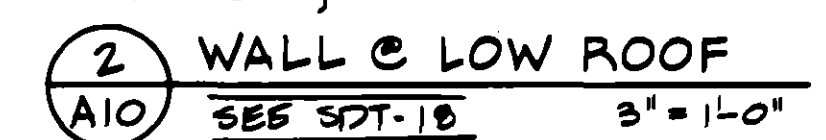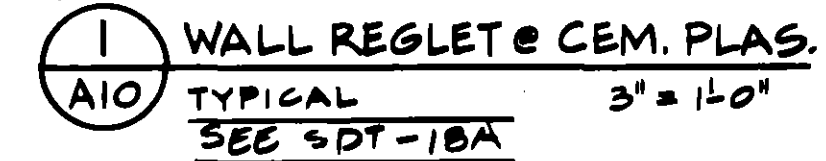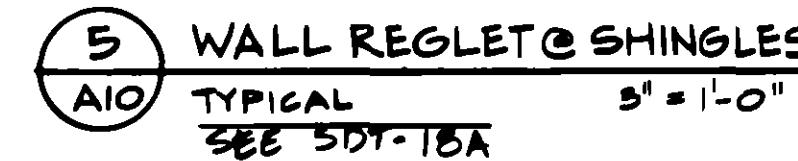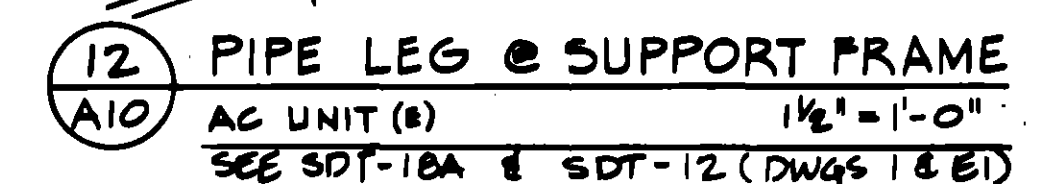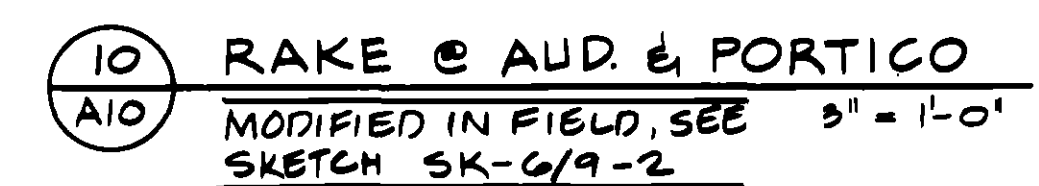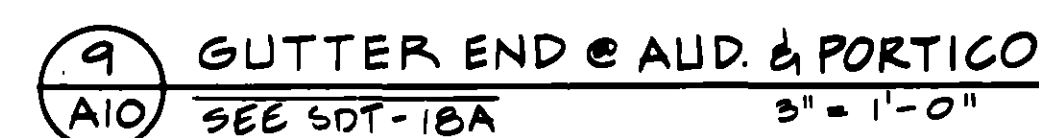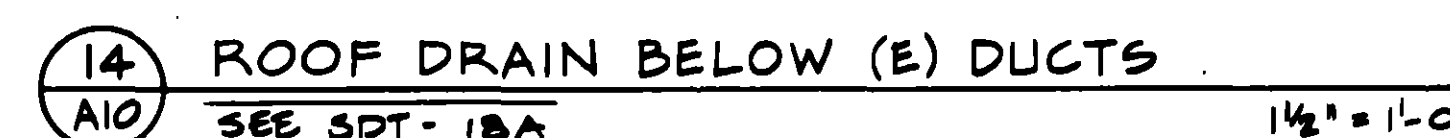



07600.11	Stainless steel gutter reinforcing channel at 2'-0" on center. Fasten each channel to existing or new wood framing with stainless steel screws, two per side.	
07600.12	Continuous stainless steel cleat.	
07600.13	Stainless steel cover flashing.	
07600.14	3 inch square new stainless steel rainwater leader. Provide 3 inch diameter round stainless steel rainwater leaders at courtyard only. See building elevations.	
07600.15	Formed stainless steel coping.	
07600.16	Formed stainless steel valley flashing with cleats.	
07600.17	Stainless steel flashing.	SEE SDT-1B
07600.18	Stainless steel step flashing.	8 SDT-1BA
07600.19	Stainless steel step flashing at sides. Continuous stainless steel flashing top and bottom. On low side set continuous flashing in bed of plastic cement and lap over asphalt shingles. At high side use elastomeric sheet flashing and lap asphalt shingles over top of continuous flashing as shown on the drawings. Solder corners as required to provide watertight flashings.	
07600.20	New stainless steel sleeves and flashings as required by relocated ducts.	
07600.21	3" x 3" stainless steel scupper, 3" x 3" MINIMUM	
07600.22	1 inch wide stainless steel drawband with stainless steel bolt and lock washer.	
07600.23	22 ga. Stainless steel watertight umbrella overlapping jacket by radius of 3 inches.	
07600.24	Stainless steel roof jack collar flashing with minimum 6 inch flanges all sides of penetration. On low side set flange in bed of mastic and lap over asphalt shingles. At high side use elastomeric strip flashing and lap asphalt shingles over top of flange as shown on the drawings.	
07600.25	Stainless steel rake drip edge.	
07600.26	2 inch stainless steel pipe (gutter overflow). Pipe shall project 2 inches above scupper inlet. Weld or solder watertight to stainless steel flashing. Project pipe through soffit and trim with stainless steel flange painted to match ceiling.	2 1/2" IN MIN. CROSS SECTIONAL AREA
07600.27	2" x 3" stainless steel overflow scupper. Inlet shall be 2 inches above scupper inlet.	
07600.28	Stainless steel flashing angle at overflow scuppers.	
07600.29	Stainless steel pan flashing at scuppers.	
07600.30	Gutter drainage: 3 inch square stainless steel tube connected with watertight weld to gutters.	
07600.31	Stainless steel Z-flashing behind shingles at steel plates.	
07600.40	Slip Sheet.	
07600.50	Stucco reglet.	SEE SDT-1B
07600.51	STX stucco reglet.	
07600.52	Two piece counter flashing assembly (similar to STX reglet).	
07600.60	Welded or soldered watertight seam.	
07900.10	Sealant. SEE SDT 1BA	
08800.10	Type 1 Glazing (clear float glass)	
08800.11	Type 2 Glazing (tempered glass)	
09206.10	Metal Lath.	
09220.10	New portland cement plaster finish.	
09220.11	Control Joint in portland cement plaster.	SEE SDT-1GC
09220.12	Corner bead in portland cement plaster.	
09220.13	Casing bead in portland cement plaster.	
09920.14	Continuous vent screed. Paint to match adjacent material.	
09900.10	1 coat alkyl primer, two finish coats latex paint (exterior wood).	
09900.11	1 coat alkyl primer, two finish coats alkyl paint (exterior cement plaster and metal). AND CONC BLOCK	SEE SDT-1BA & SDT-1BB
09250.10	Gypsum wallboard.	
E.1	Existing rainwater leader.	
E.2	Existing asphalt paving and new concrete retaining wall. See civil drawings.	
E.3	Existing expansion joints in cement plaster.	
E.4	Existing mechanical equipment on concrete pad.	
E.5	Existing cement plaster wall.	
E.6	Existing windows.	
E.7	Existing ducts.	
E.8	Existing wood framing. Verify size and condition in field.	
E.9	Existing mechanical equipment curb.	
E.10	Existing kitchen exhaust hood. Remove and reinstall after installation of new flashings and roofing.	
E.11	Existing electrical conduits.	

Phase 2
Project 3368

DRAWN PG	DATE 7/17/91
CHECK JG	JOB NO. 0620.010

A-10

2-9/3

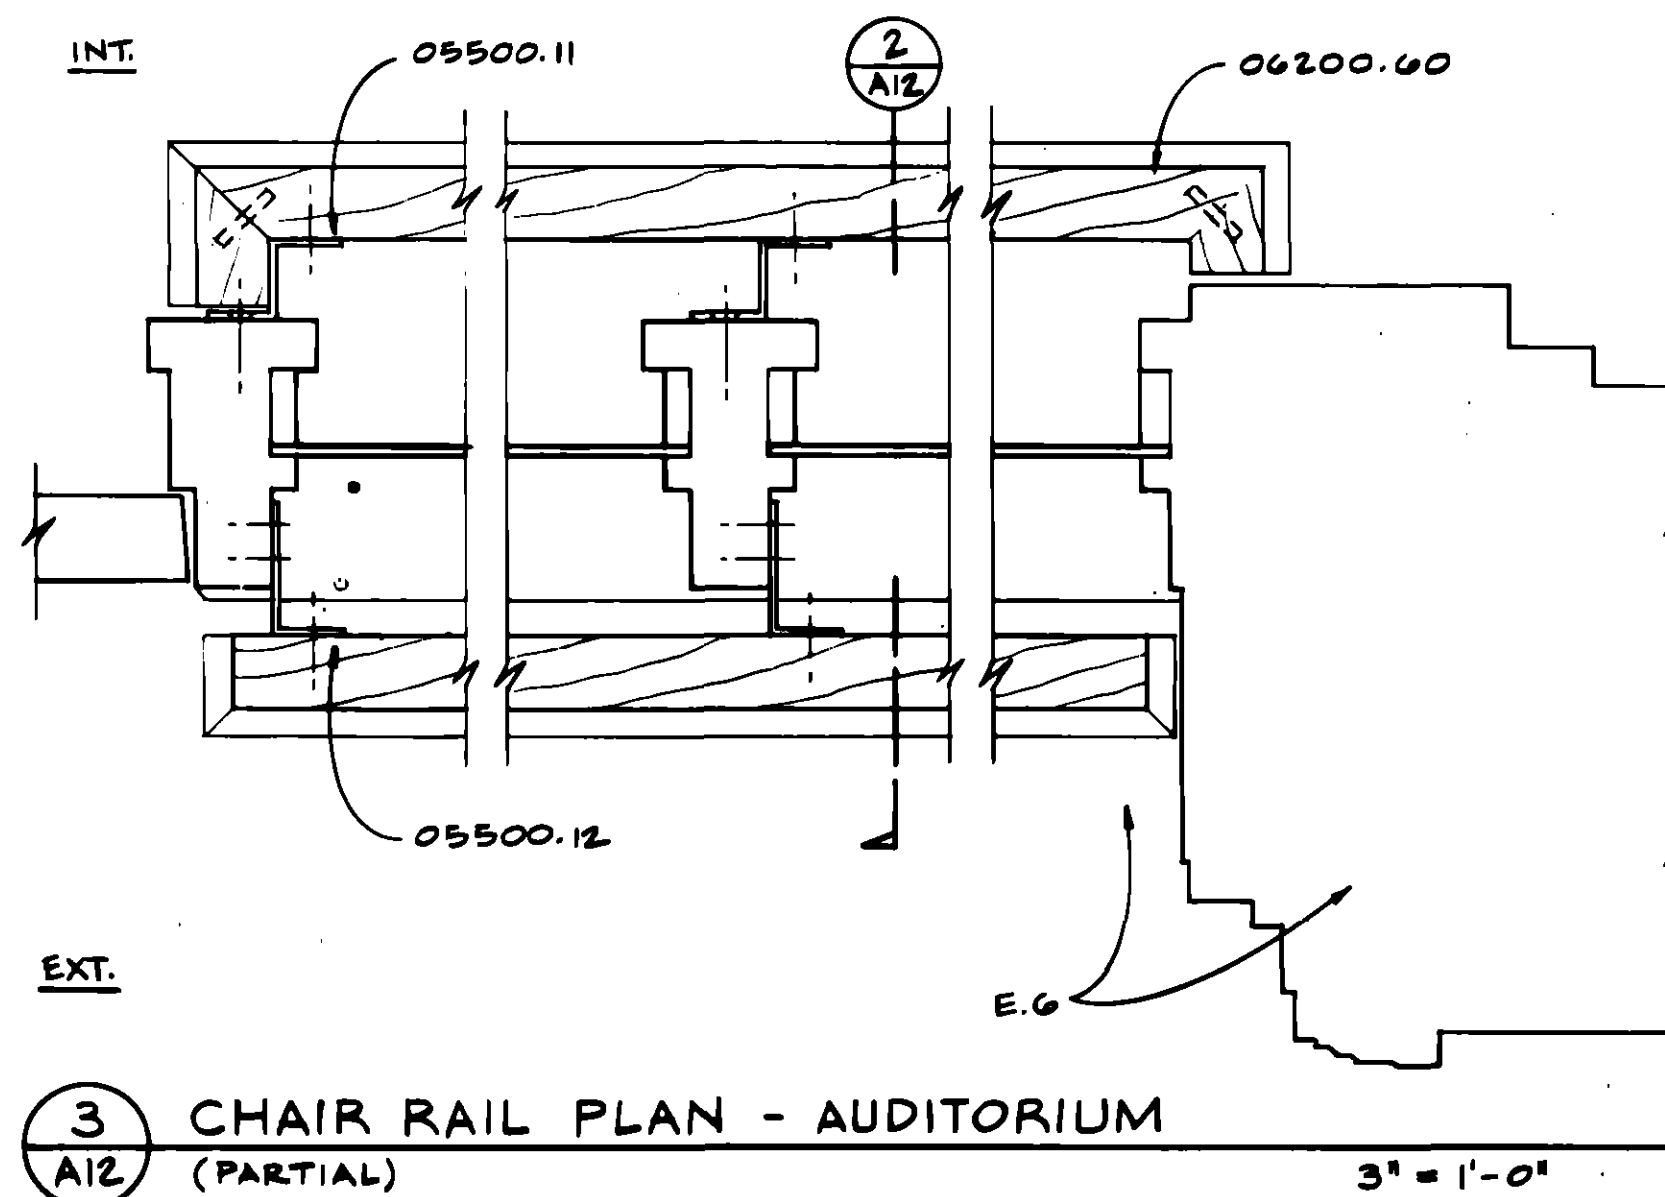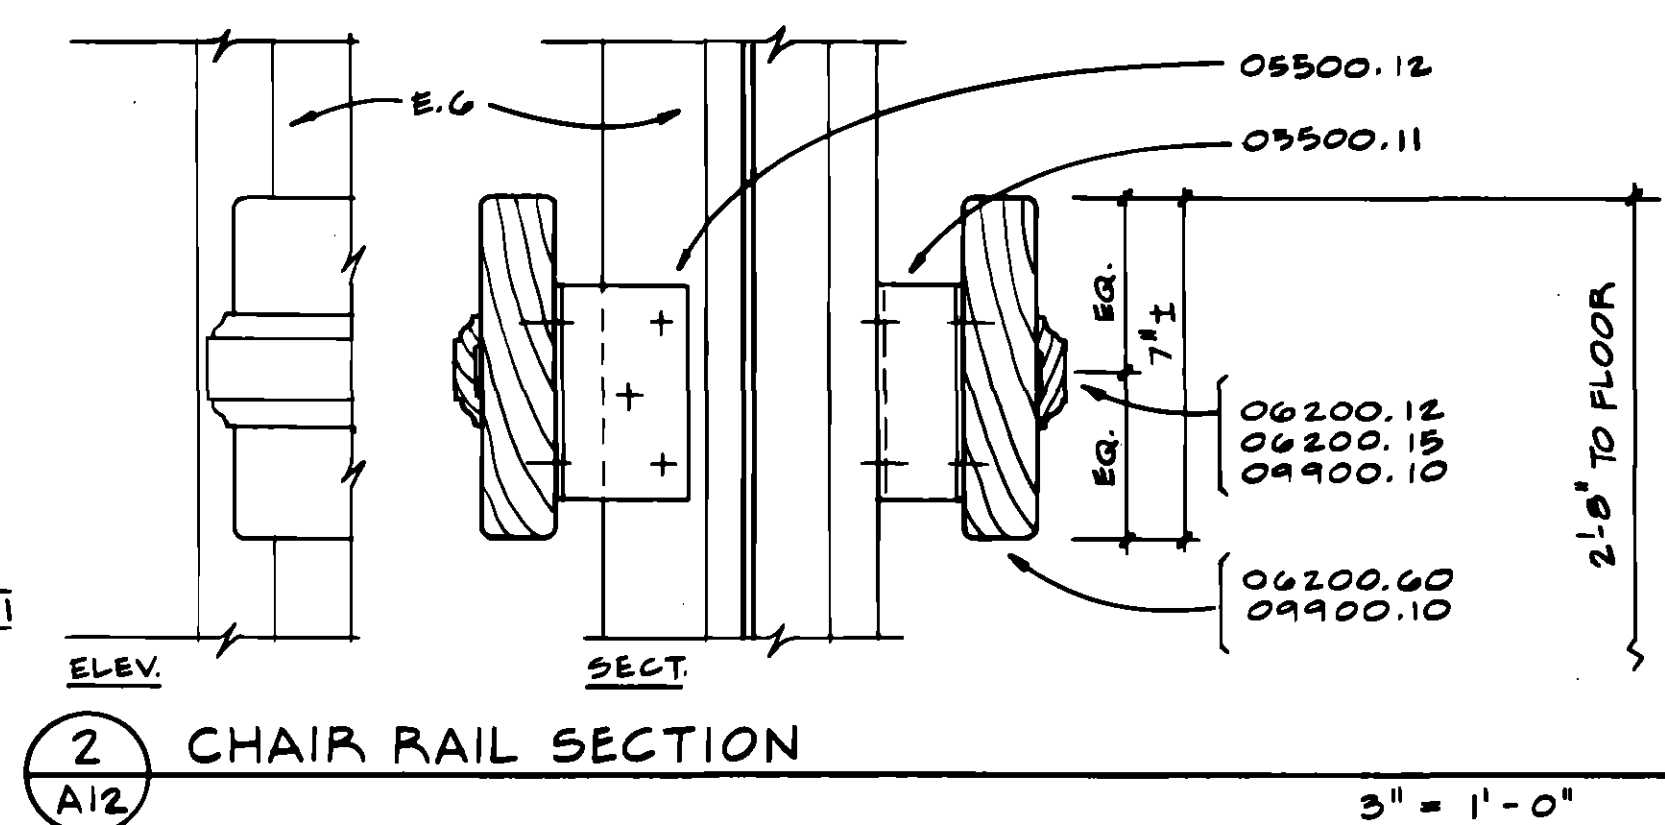

<p>CITY OF MILPITAS MILPITAS SENIOR CENTER Repair and Restoration Project Phase 2 <i>Project 3368</i></p>	<p>GROSSMANN DESIGN GROUP ARCHITECTURE PLANNING RESEARCH 151 Townsend Street San Francisco, CA 94107 415-543-8618</p>
---	---

DATE	ACTION	CH
01/17/91	ISSUED FOR CLIENT APPROVAL	
01/17/91	RECEIVED FROM CLIENT	

DRAWN PG	DATE 7/17/91
CHECK JG	JOB NO. 0620.010

A-12

RECORD DRAWING
4-1-88

M-1
14/24

2-9/3

(4) PAIR OF REFRIGERANT LINES
EACH PAIR = 3/8" ODL AND 3/4" ODS
SEE SDT-1B (20, 21)

CONNECT TO EXISTING RISERS ABOVE CEILING.

PROVIDE 18 GA. STAINLESS STEEL ENCLOSURE
FOR REFRIGERANT LINES BETWEEN WALL AND
CONCRETE BASE. FLASH AT WALL (SEE
SPECIFICATIONS).

EXISTING HEAT PUMPS

REMOVE EXISTING AC UNIT AND RESET
ON NEW STRUCTURAL BASE WITH
VIBRATION MOUNTS. SEE
SPECIFICATIONS.
SEE SDT-1B
RECONNECT WITH NEW SUPPLY AND RETURN
LINED DUCTS WITH FLEX CONNECTION.
SEE SDT-1B (16, 17, 18, 19) & SDT-1B C

(E) KITCHEN EVAP. COOLER TO REMAIN

KEEP THIS RUN AS
SHORT AS POSSIBLE

NOTES

1. Each refrigerant line on the drawing represents a liquid line plus a suction/hot gas line.
2. The Contractor shall verify matching of heat pump with respective fan coils.
3. Remove all existing refrigerant lines above the roof and cut back risers for new connections as shown.
4. Remove all exposed refrigerant line insulation and re-insulate all suction lines (new and remaining).
5. Locate all refrigerant lines above finished ceilings. Wherever possible locate new refrigerant lines above acoustical ceiling but below plaster ceiling.

SUSPENDED DX FAN-COIL UNIT (TYP.)


3/8" ODL AND 7/8" ODS

EXISTING HEAT PUMPS

PROVIDE 18 GA. STAINLESS STEEL ENCLOSURE
FOR REFRIGERANT LINES BETWEEN WALL AND
CONCRETE BASE. FLASH AT WALL (SEE
SPECIFICATIONS).

CONNECT TO EXISTING RISERS ABOVE CEILING.


(3) PAIRS OF REFRIGERANT LINES
EACH PAIR = 3/8" ODL AND 7/8" ODS
SEE SDT-1B (20, 21)

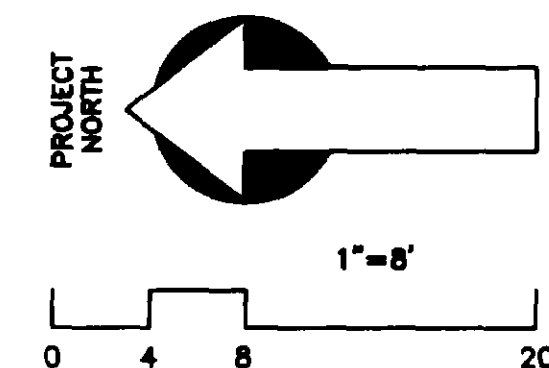

RECORD DRAWING 4-1-83	
GROSSMANN DESIGN GROUP ARCHITECTURE PLANNING RESEARCH 151 Townsend Street San Francisco, CA 94107 415-543-8618	
CITY OF MILPITAS MILPITAS SENIOR CENTER Repair and Restoration Project Phase 2 Project 3368	MECHANICAL PLAN
DRAWN UG	DATE 7/17/91
CHECK AZ	JOB NO. 0620.010
SHEET M-1	

2-9/3

15/24

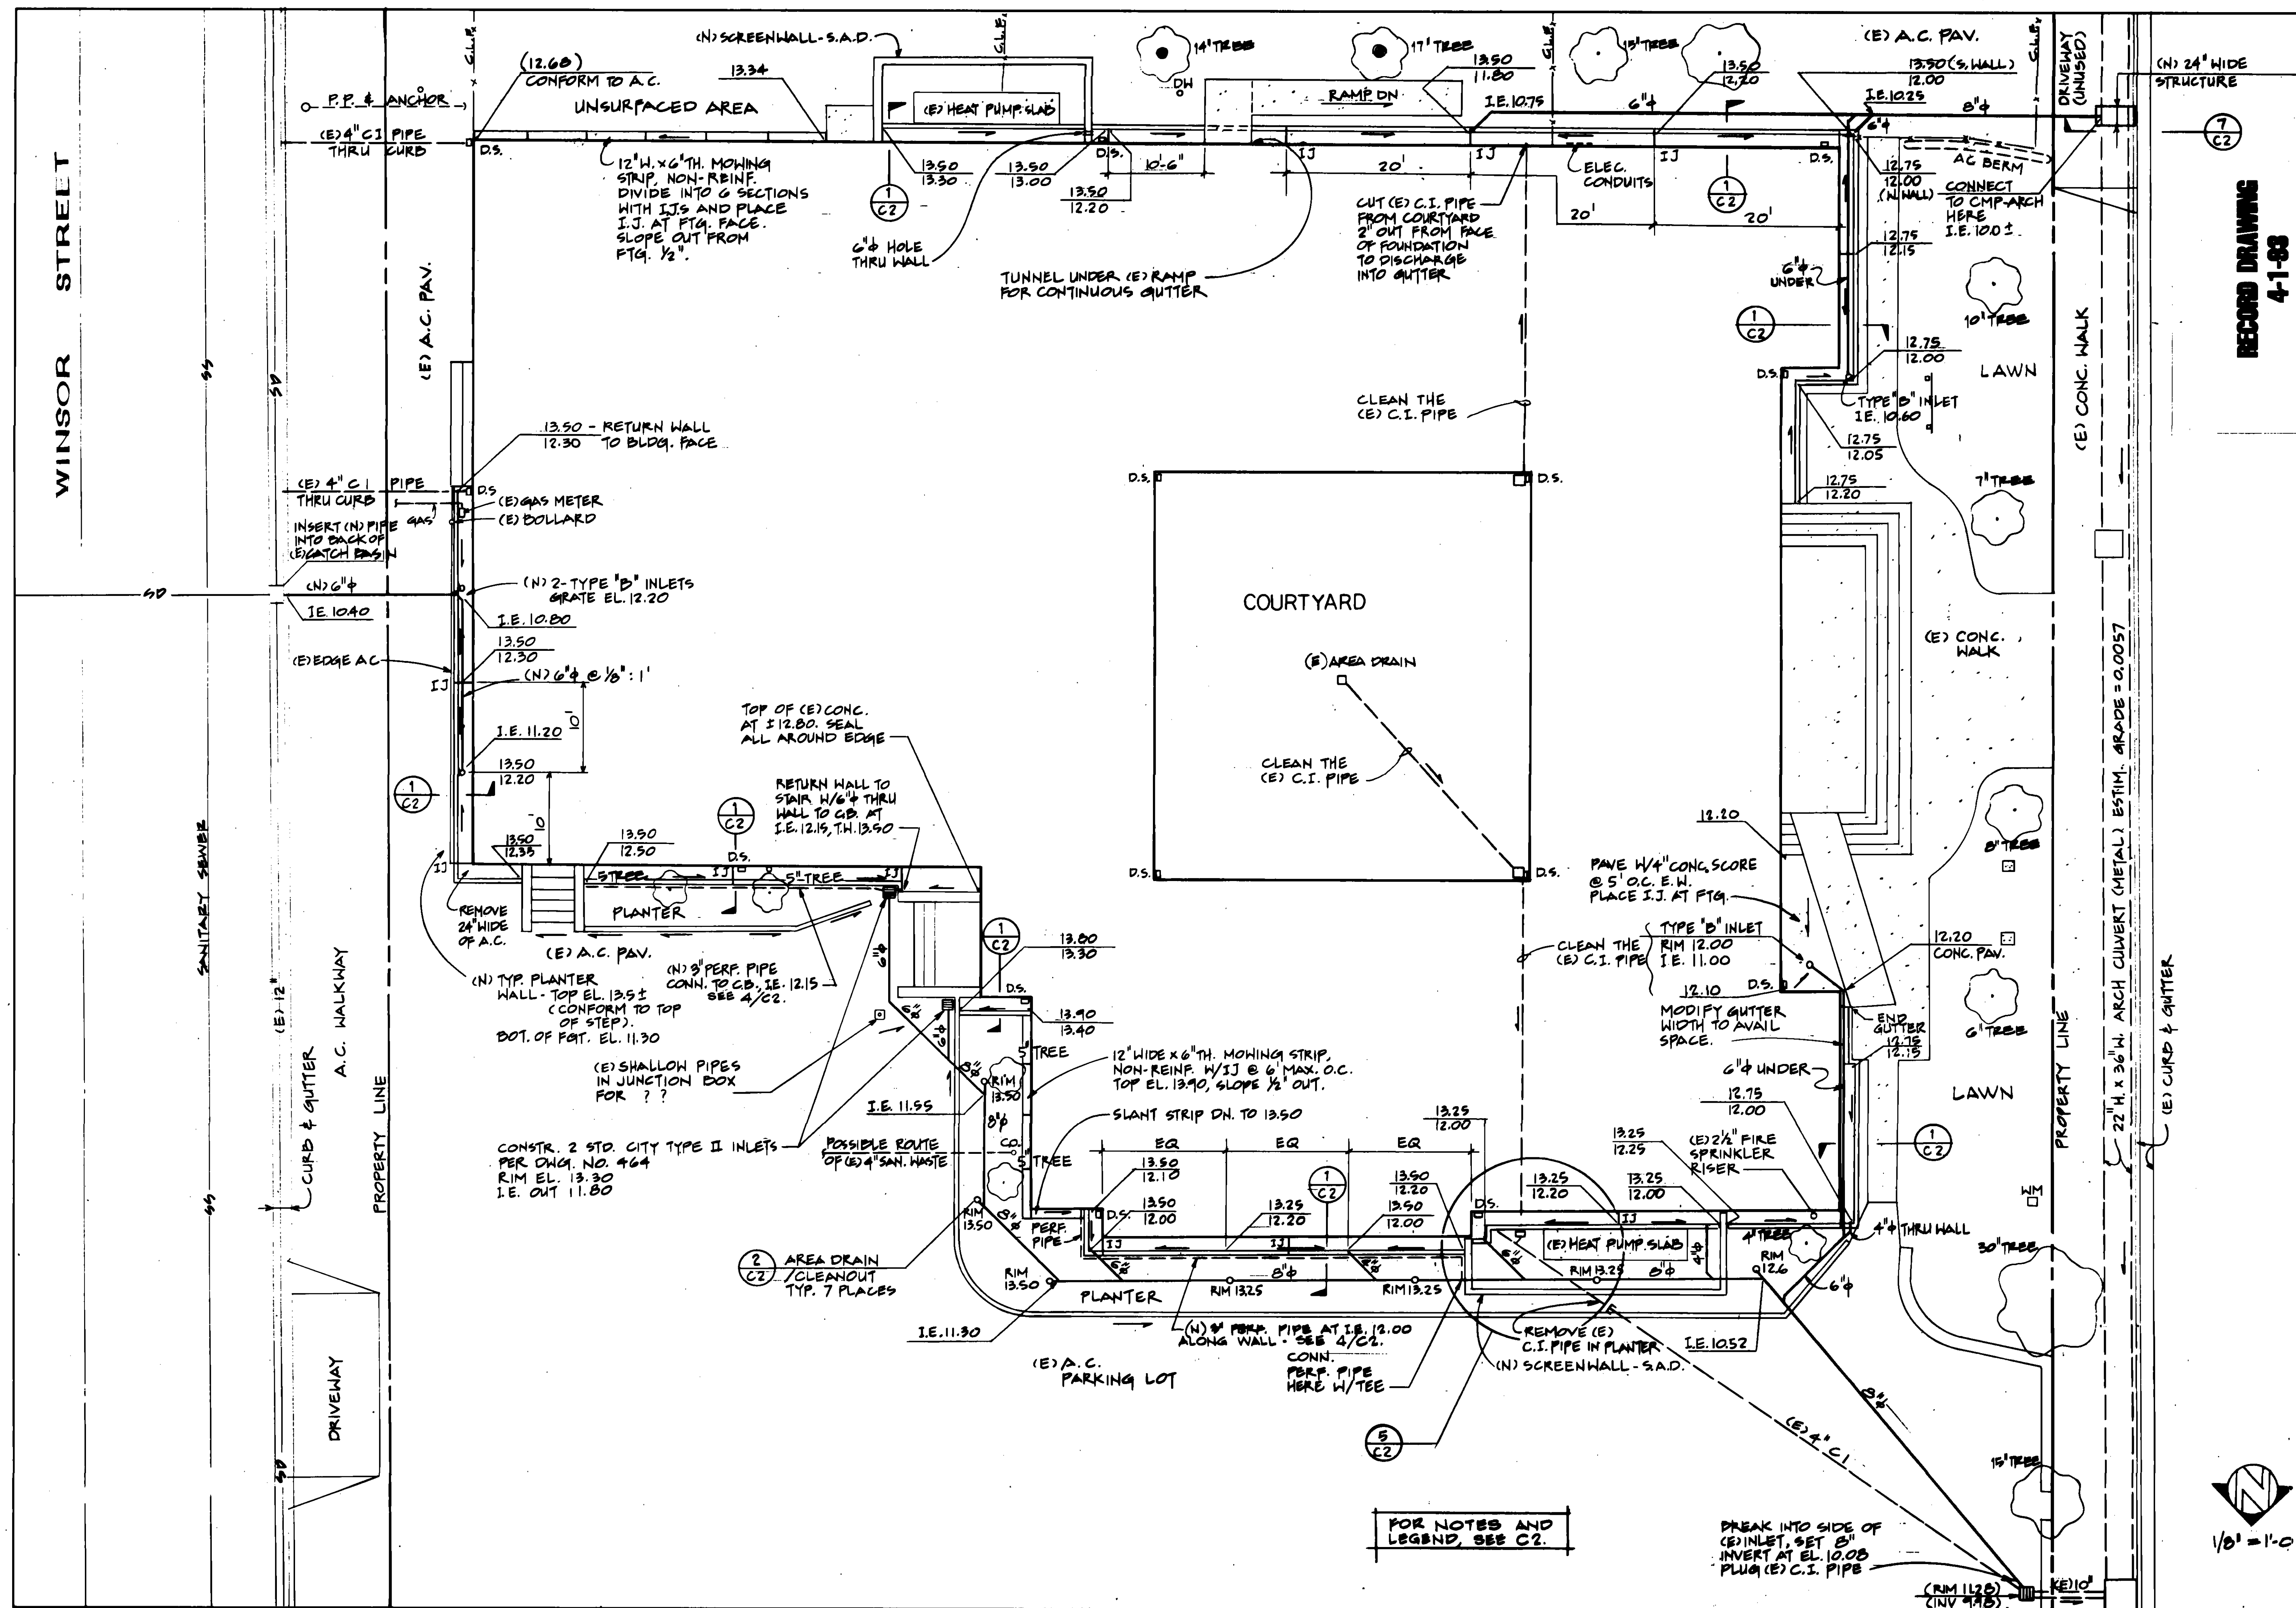

RECORD DRAWING
4-1-88

NORTH MAIN STREET

CITY OF MILPITAS
MILPITAS SENIOR CENTER
Repair and Restoration Project
Phase 2
Project 3366


GROSSMANN DESIGN GROUP
ARCHITECTURE PLANNING RESEARCH
151 Townsend Street
San Francisco, CA 94107
415-543-8618

SEAL
Professional Engineer
No. 14553
Exp. 3/31/91
JAMES RUSSELL
DIVISION OF ENGINEERING
CIVIL ENGINE
Phone: 415/486-4222
Rutherford & Curren
Consulting Engineers
303 Second St. #800N
San Francisco, CA 94107
Phone: 415/486-4222

SITE DRAINAGE PLAN	
DRAWN KN	DATE 7-17-81
CHECK JAR	JOB NO. 0820.010
SHEET	

C1


2-9/13
10/64

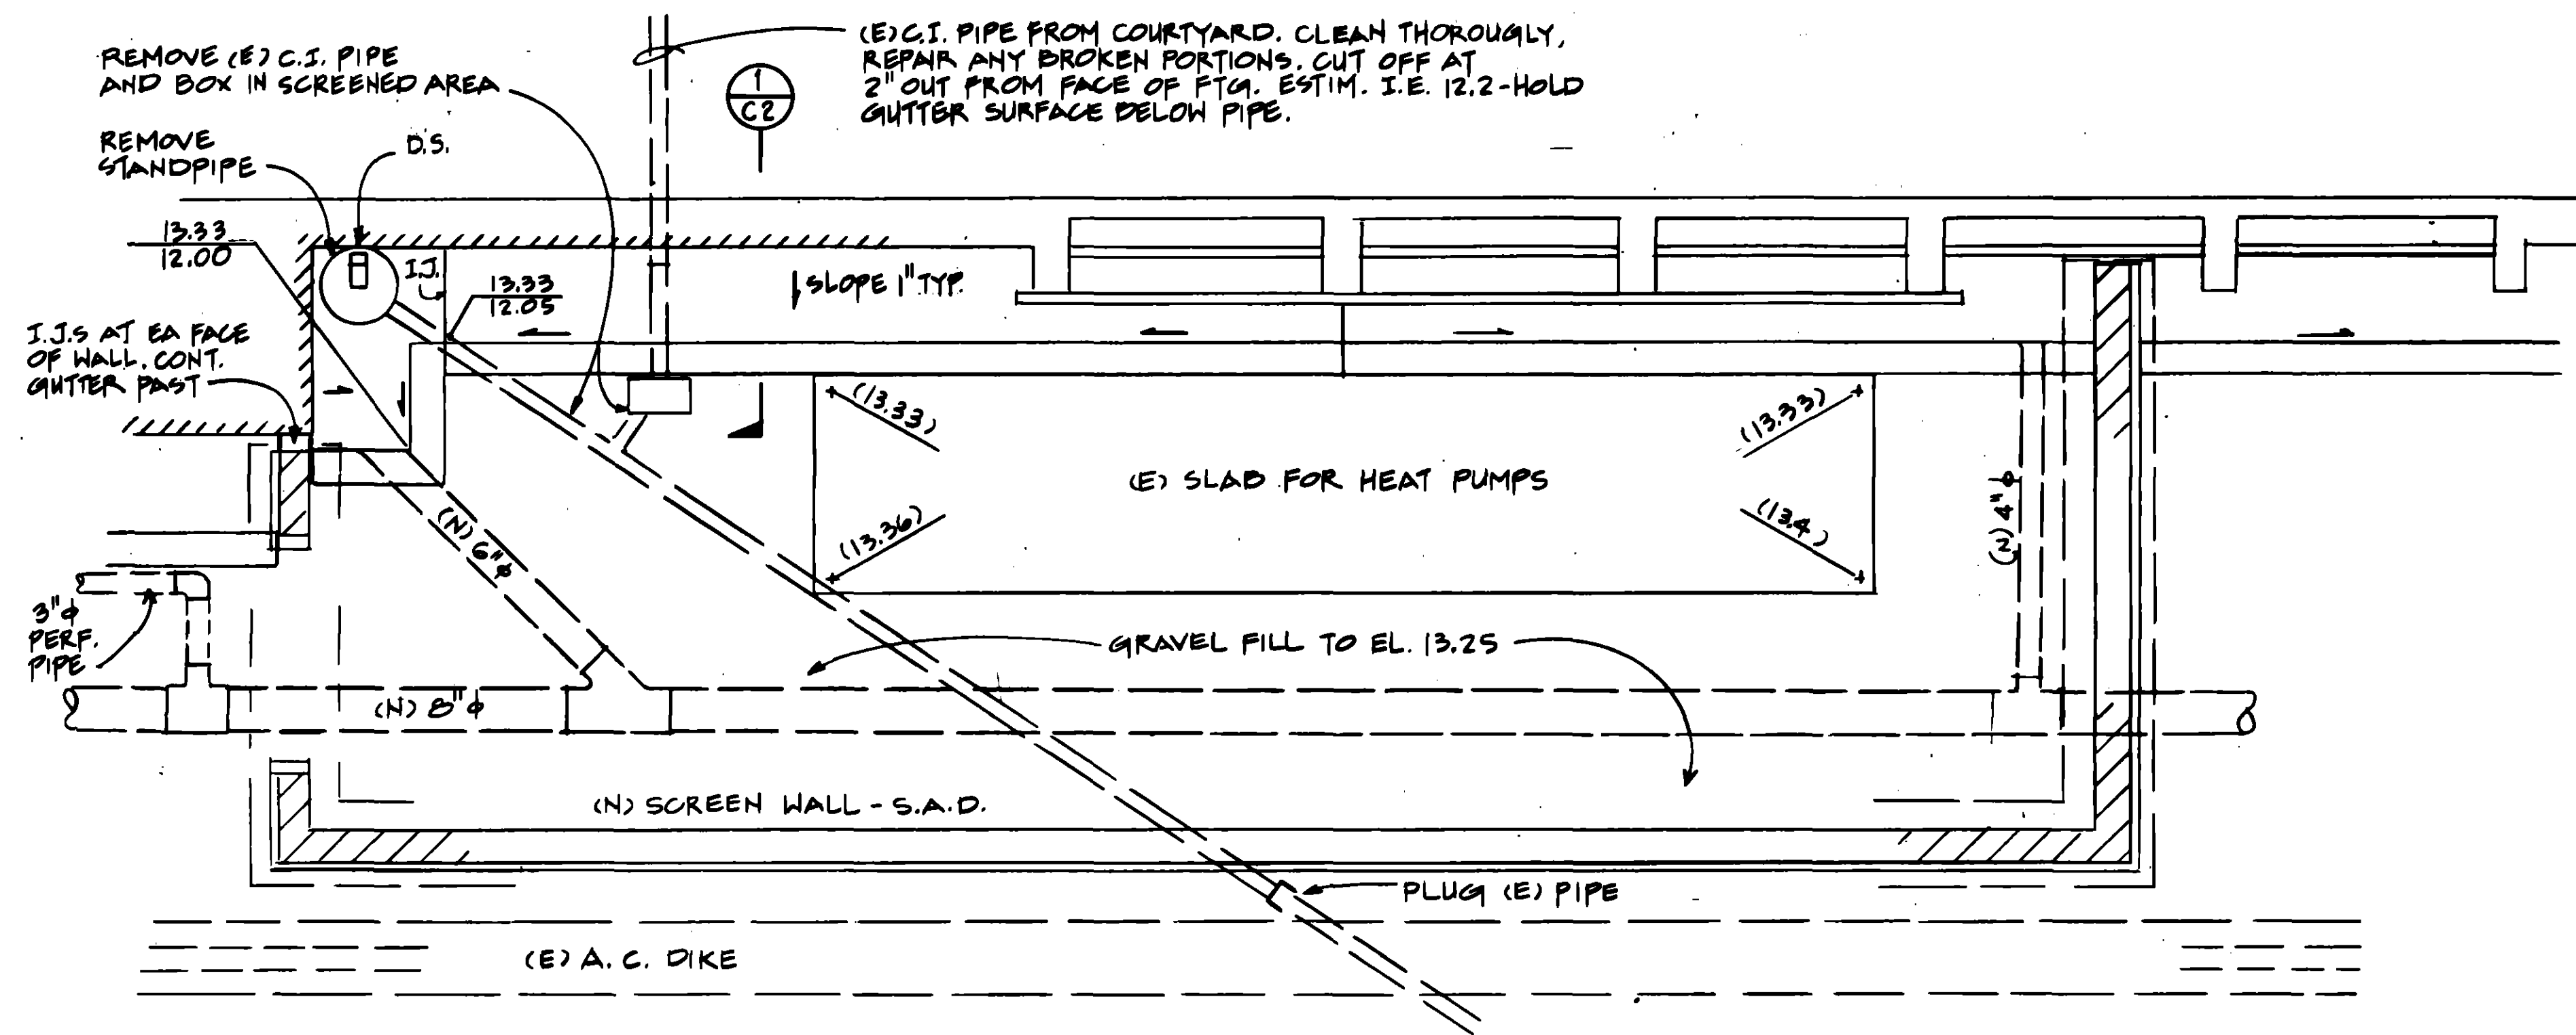

PLAN DETAIL

1/2" = 1'-0"

5

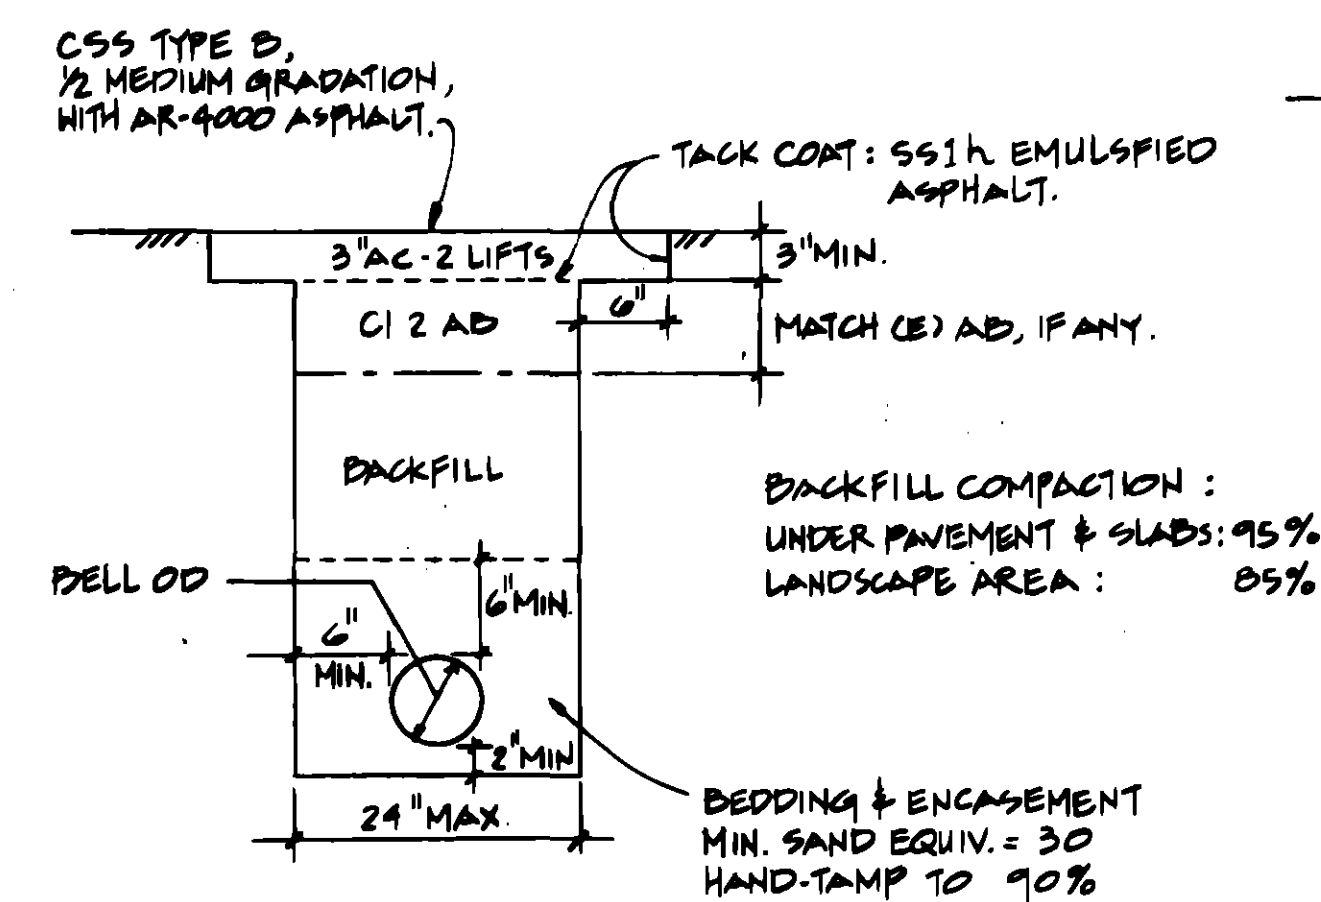


TYPICAL TRENCH

SECTION

NO SCALE

11

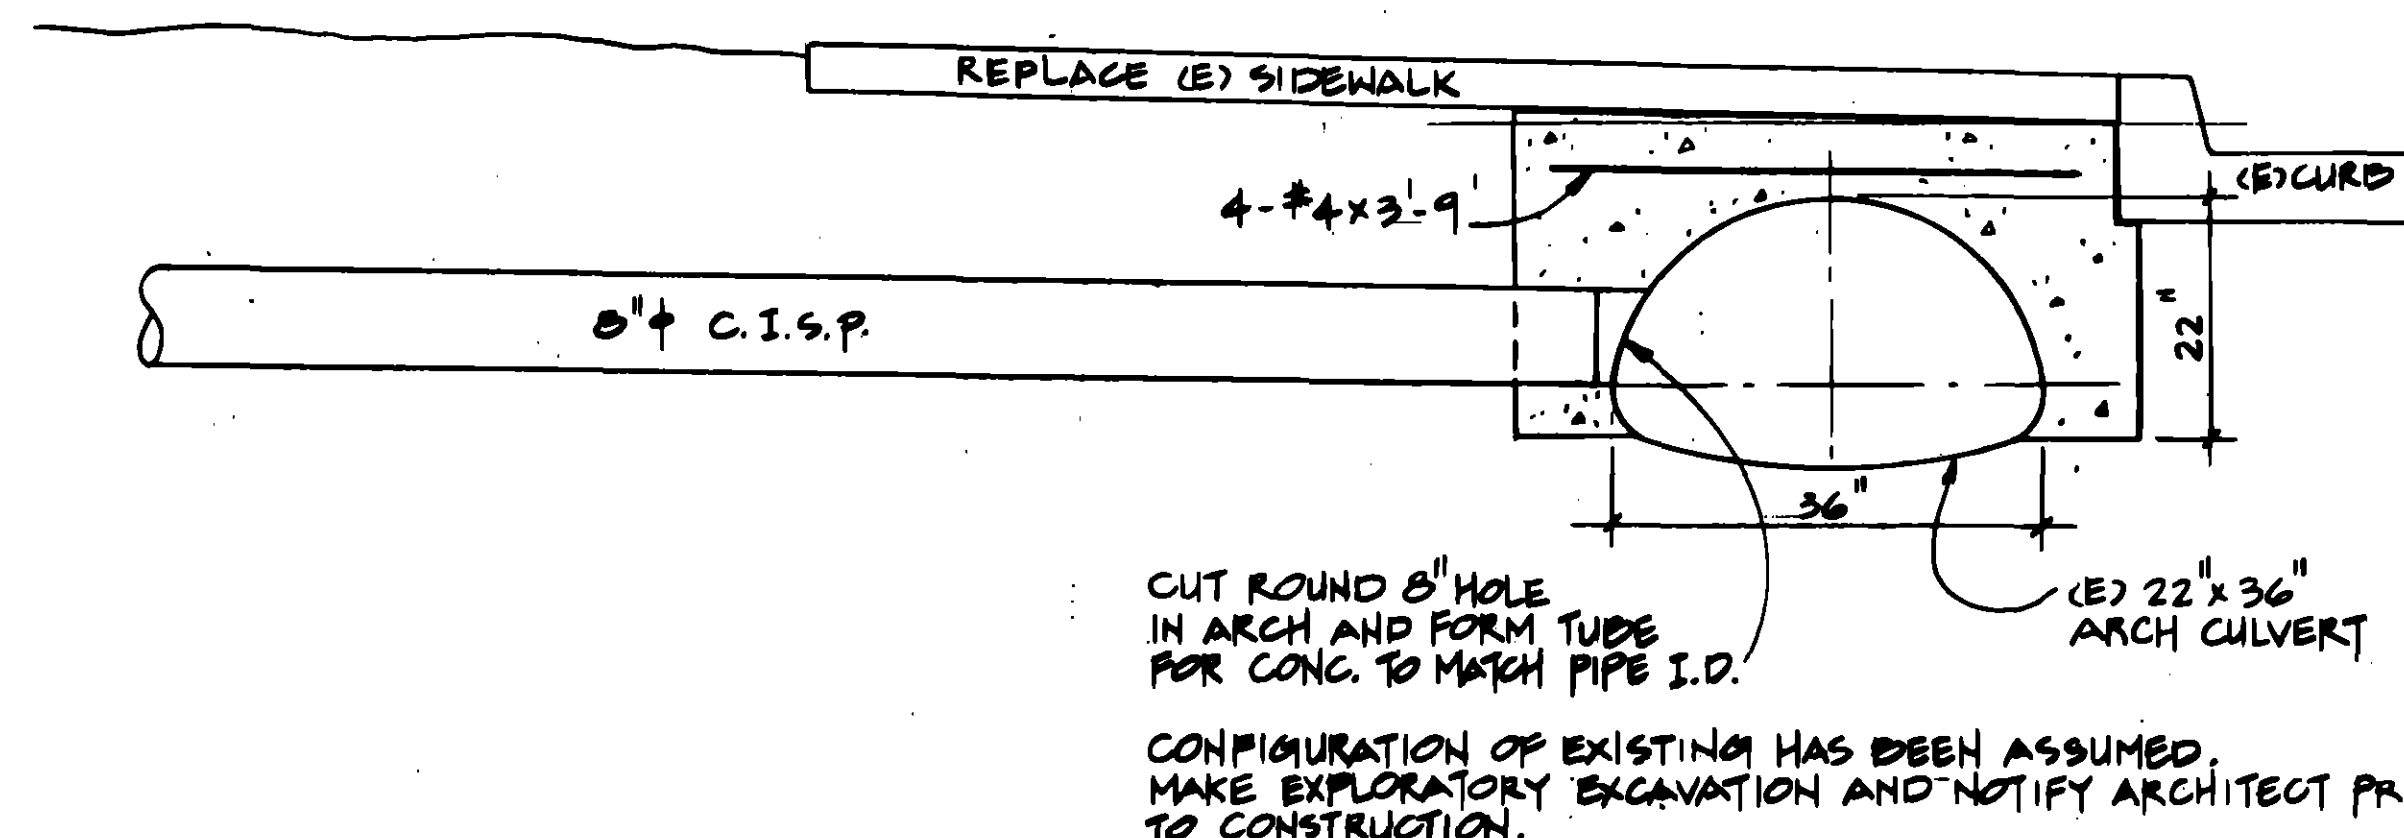


ARCH JUNCTION REINFORCEMENT

SECTION

3/4" = 1'-0"

7

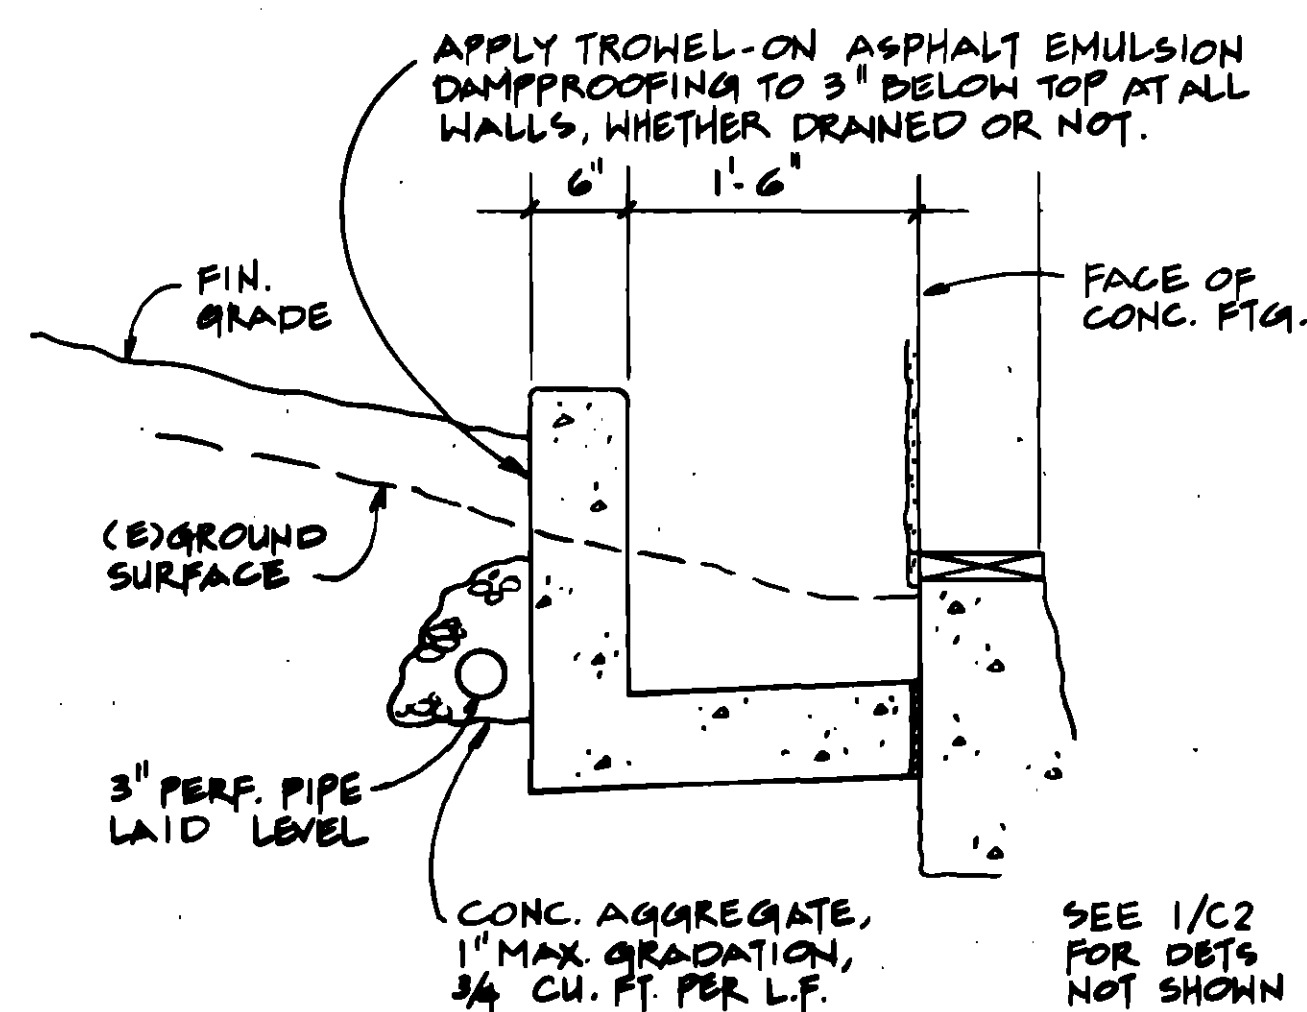


PLANTER DRAINAGE
WHERE SHOWN ON PLAN

SECTION

1/2" = 1'-0"

4

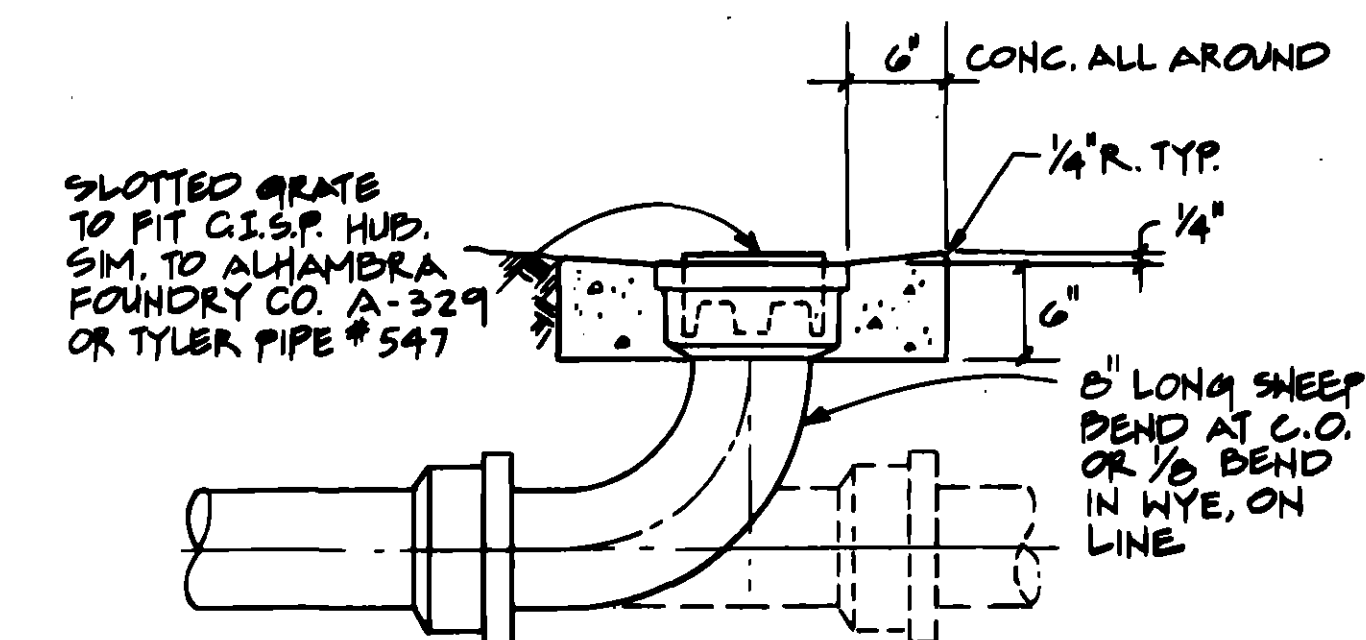


FOR TYPE "D" INLET, USE 6" QUARTER BEND & GRATE

CLEANOUT / AREA DRAIN

1" = 1'-0"

2

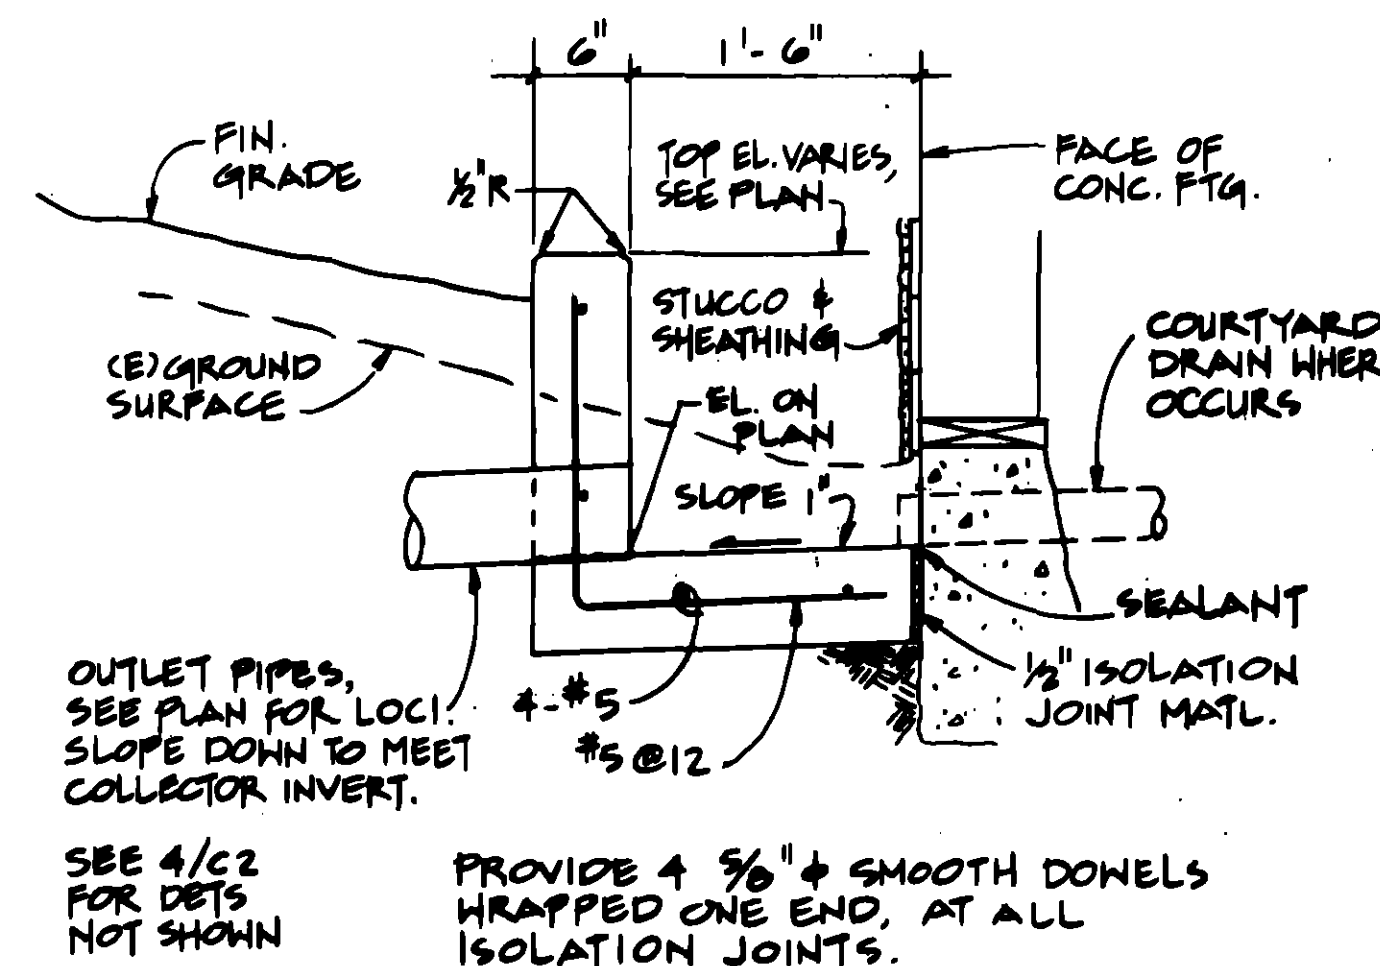

FOUNDATION GUTTER

SECTION

1/2" = 1'-0"

1

GENERAL NOTES:


1. ALL NEW SOLID WALL PIPE INDICATED SHALL BE CAST IRON SOIL PIPE, BELL AND SPIGOT TYPE, OR HUBLESS. SEE SOT-2B.
2. PERFORATED PIPE SHALL BE 3" DIAMETER SLOTTED CORRUGATED POLYETHYLENE TUBING CONFORMING TO ASTM F408, WITH FACTORY-APPLIED NYLON FILTER FABRIC.
3. SEAL ALL GUTTER JOINTS WITH TWO-PART URETHANE, TYPE M, CLASS 25 SEALANT, COLOR TO MATCH CONCRETE, AND INSTALLED IN STRICT CONFORMANCE WITH MANUFACTURER'S INSTRUCTIONS INCLUDING USE OF PRIMER AND BACKER ROD. PROVIDE 1/2" FIBER JOINT FILLER MATERIAL AT ALL I.J.s.

ABBREVIATIONS AND SYMBOLS

(E)	EXISTING
(N)	NEW
6"φ	(SIZE) OF NEW PIPE
I.J.	ISOLATION JOINT
EL.	ELEVATION
I.E.	INVERT ELEVATION
C.I.S.P.	CAST IRON SOIL PIPE
C.I.	CAST IRON
S.A.D.	SEE ARCHITECTURAL DRAWINGS
C.O.	CLEANOUT
13.50	TOP OF GUTTER WALL ELEVATION
12.00	BOTTOM OF GUTTER WALL ELEVATION

RECORD DRAWING
4-1-83

Author: J. P. P. P.
Checked: J. P. P. P.
GROSSMANN & CHICKEN
Consulting Engineers
303 Second St. #800N
San Francisco, CA 94107
Phone: 415/465-4222

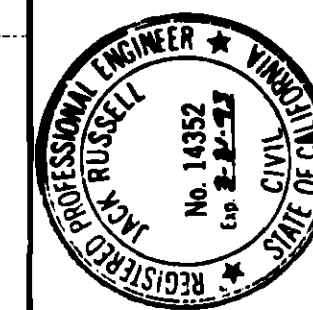








GROSSMANN DESIGN GROUP
ARCHITECTURE PLANNING RESEARCH
151 Townsend Street
San Francisco, CA 94107
415-543-8618

CITY OF MILPITAS
MILPITAS SENIOR CENTER
Repair and Restoration Project
Phase 2
Project 3368

DETAILS			
REVISION	DATE	ACTION	CHECKED
8-1-91	7-17-91	REVISION FOR CLIENT APPROVAL	JAR
DRAWN	DATE	CHECKED	JAR
KN	7-17-91	JOB NO.	0620.010
SHEET			

C2

S2.1
10/24
2-9/3

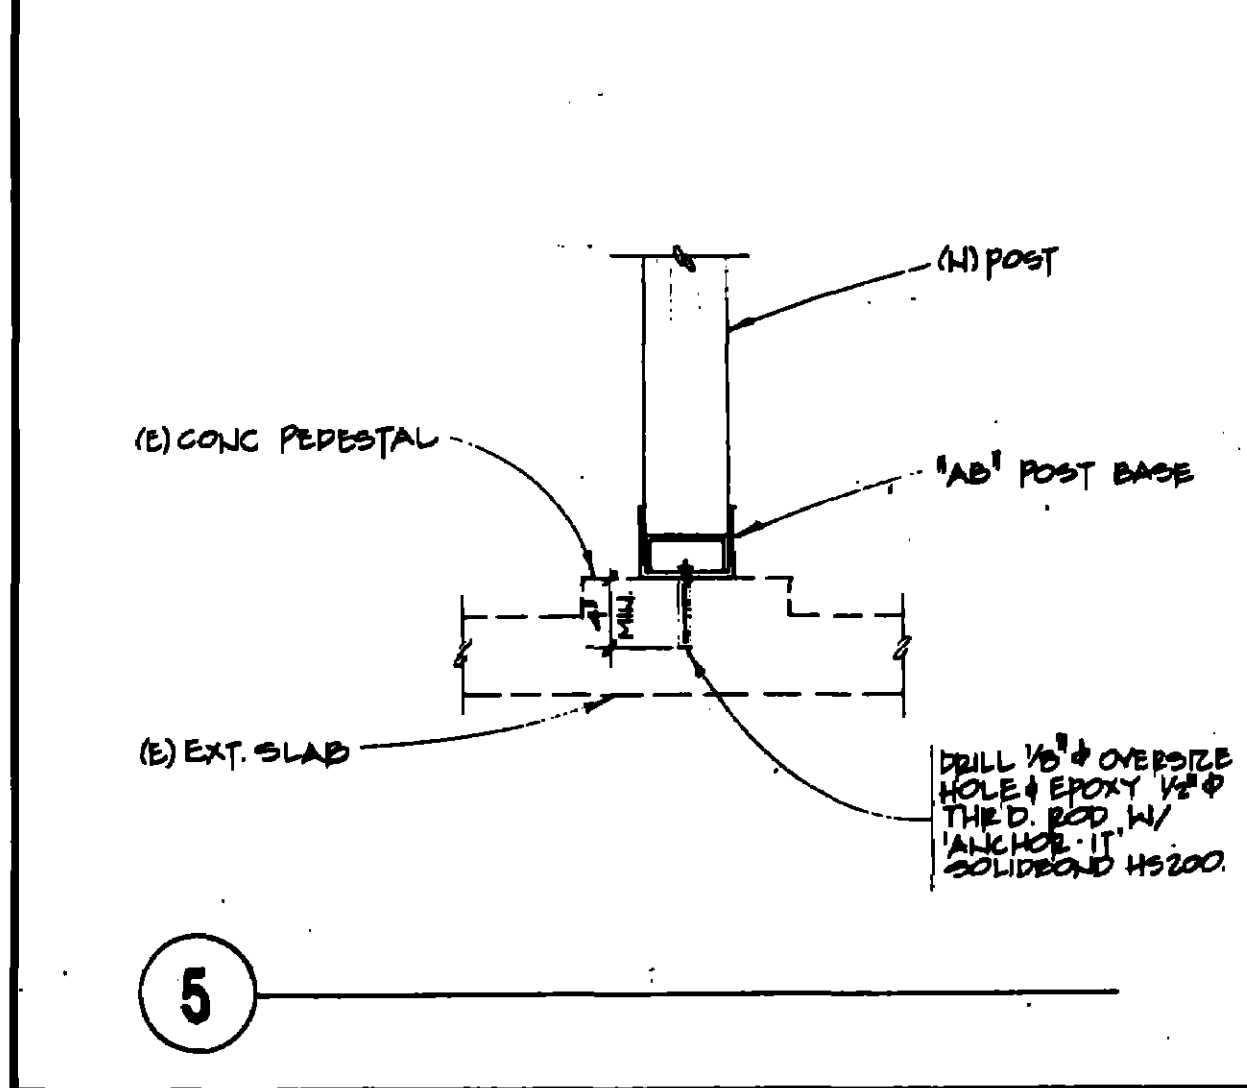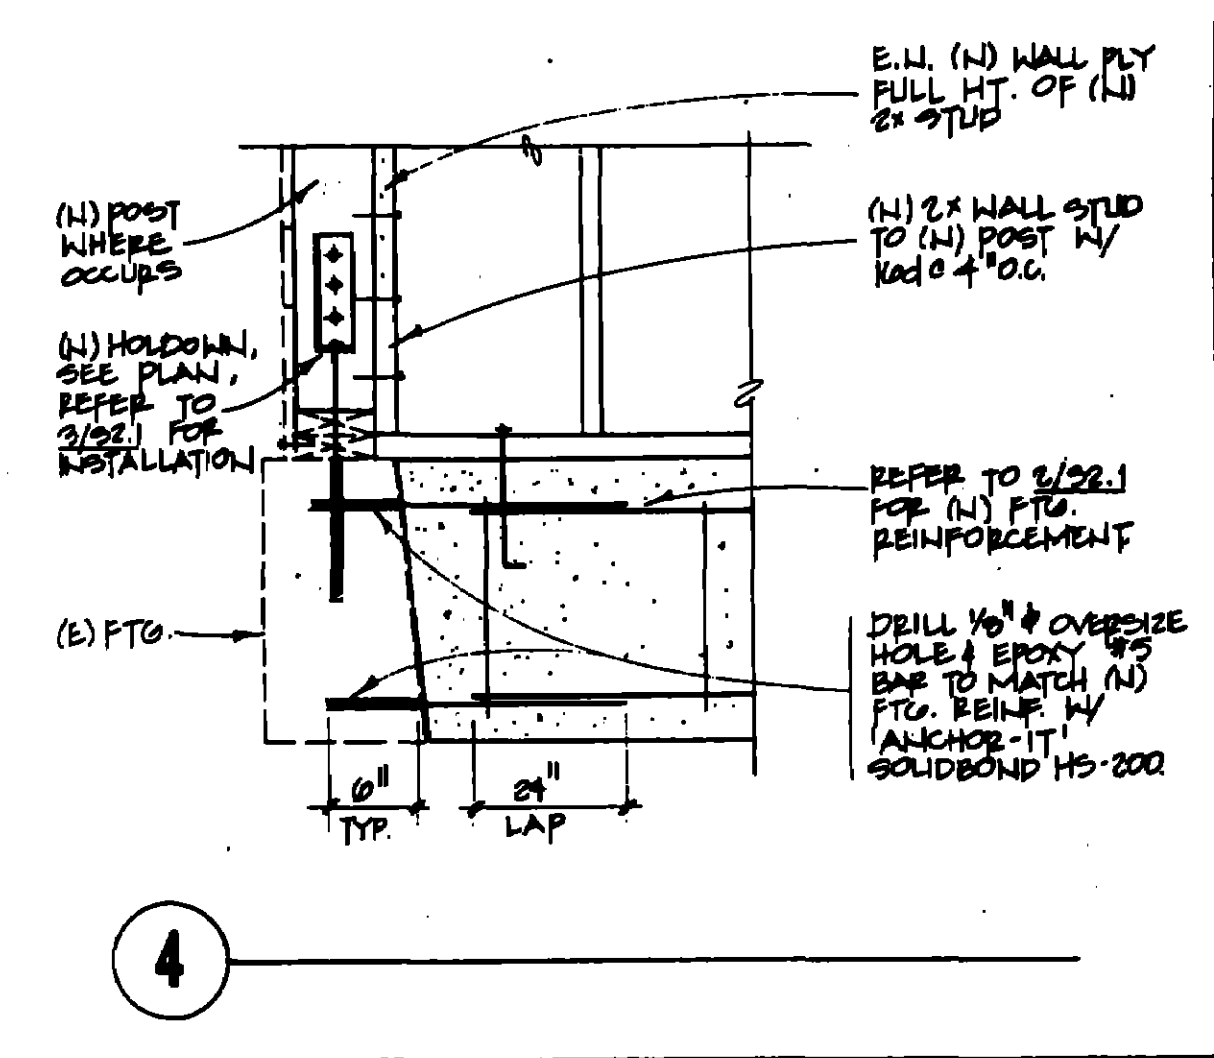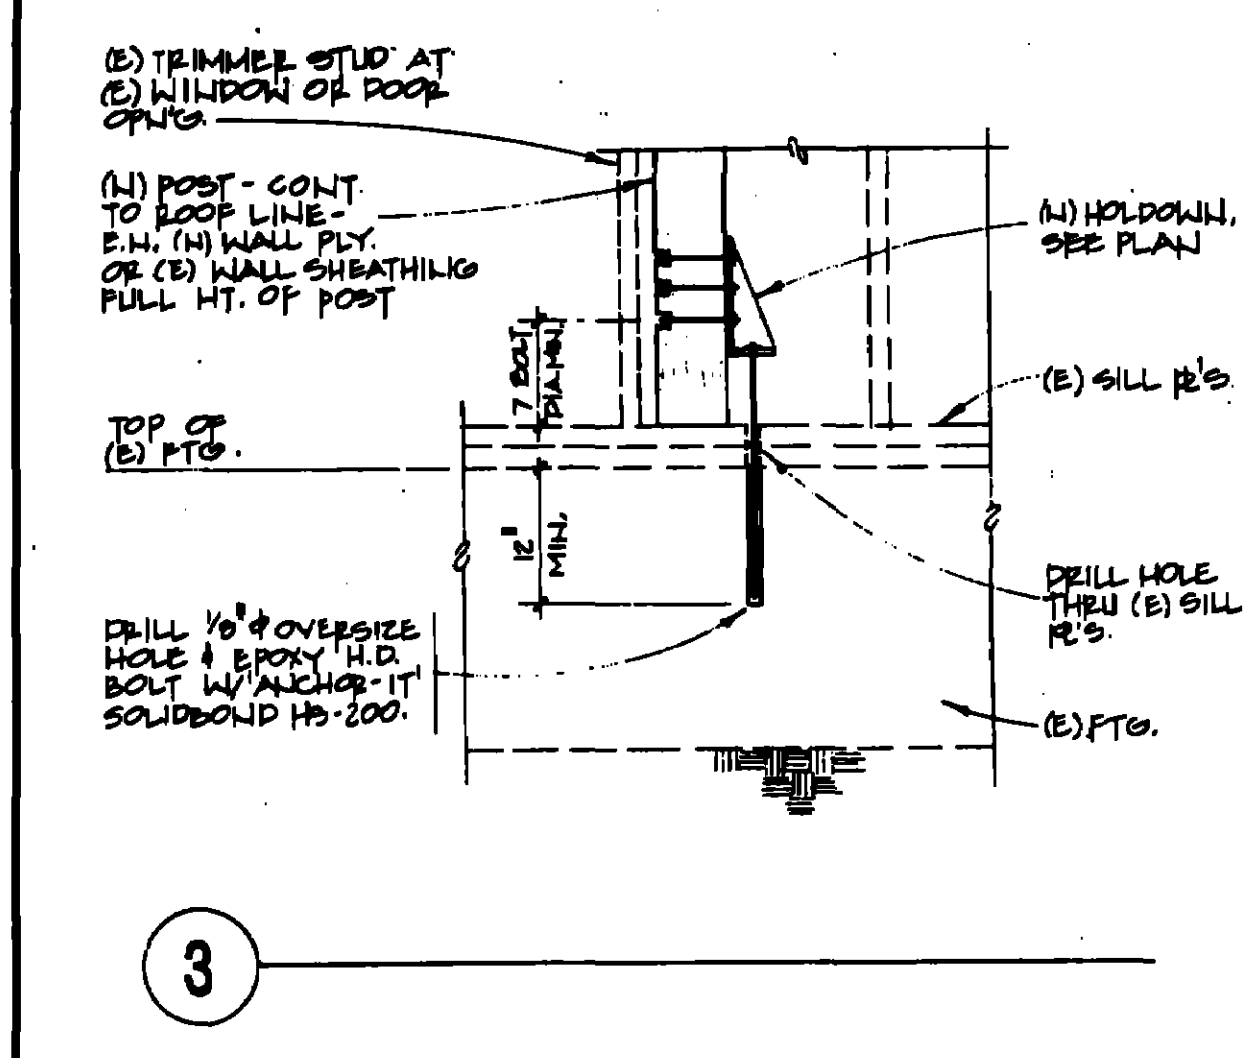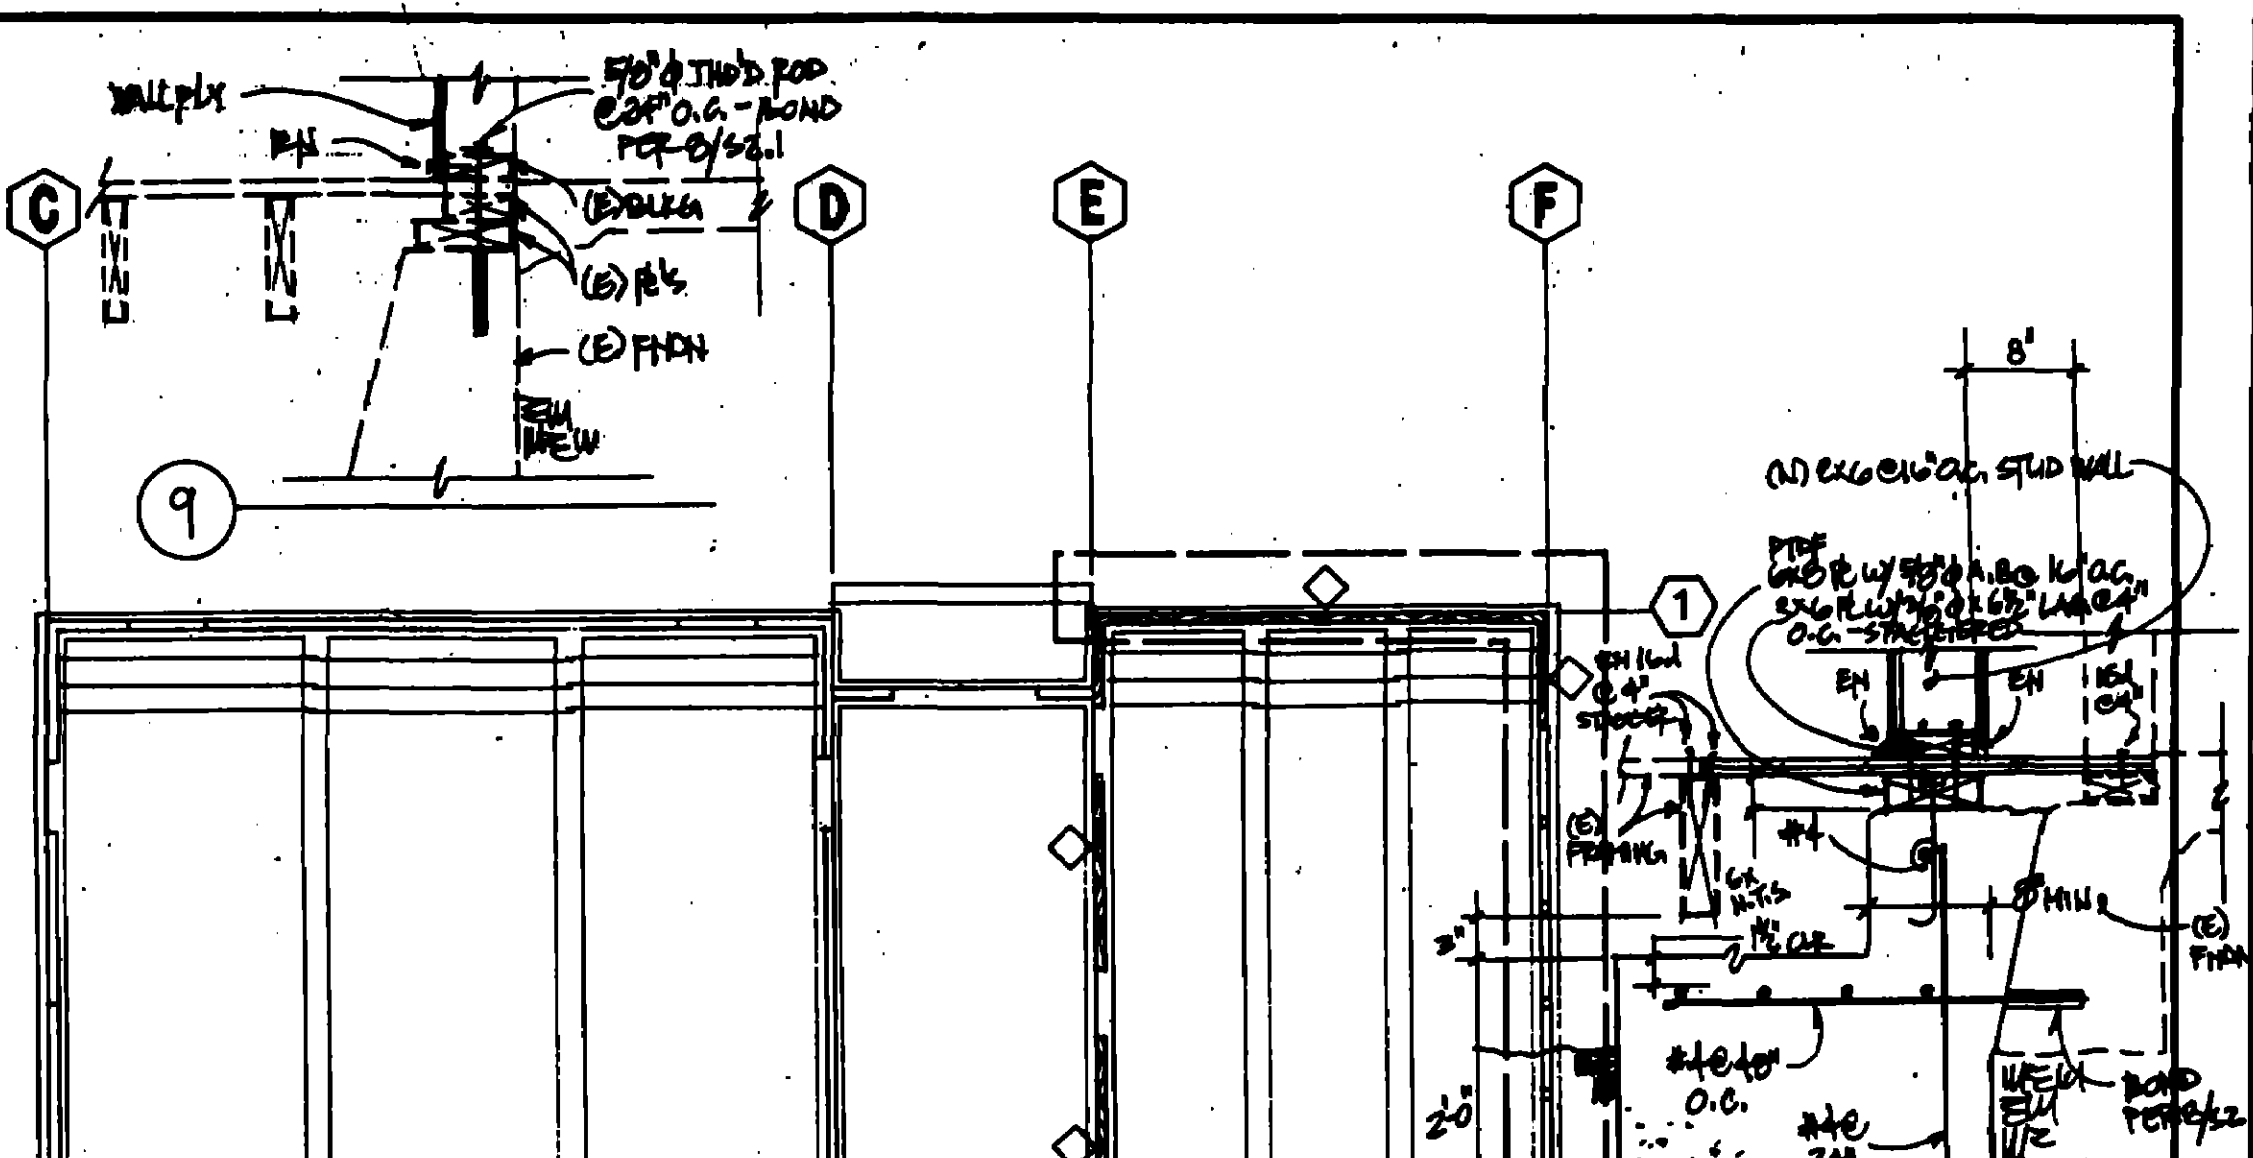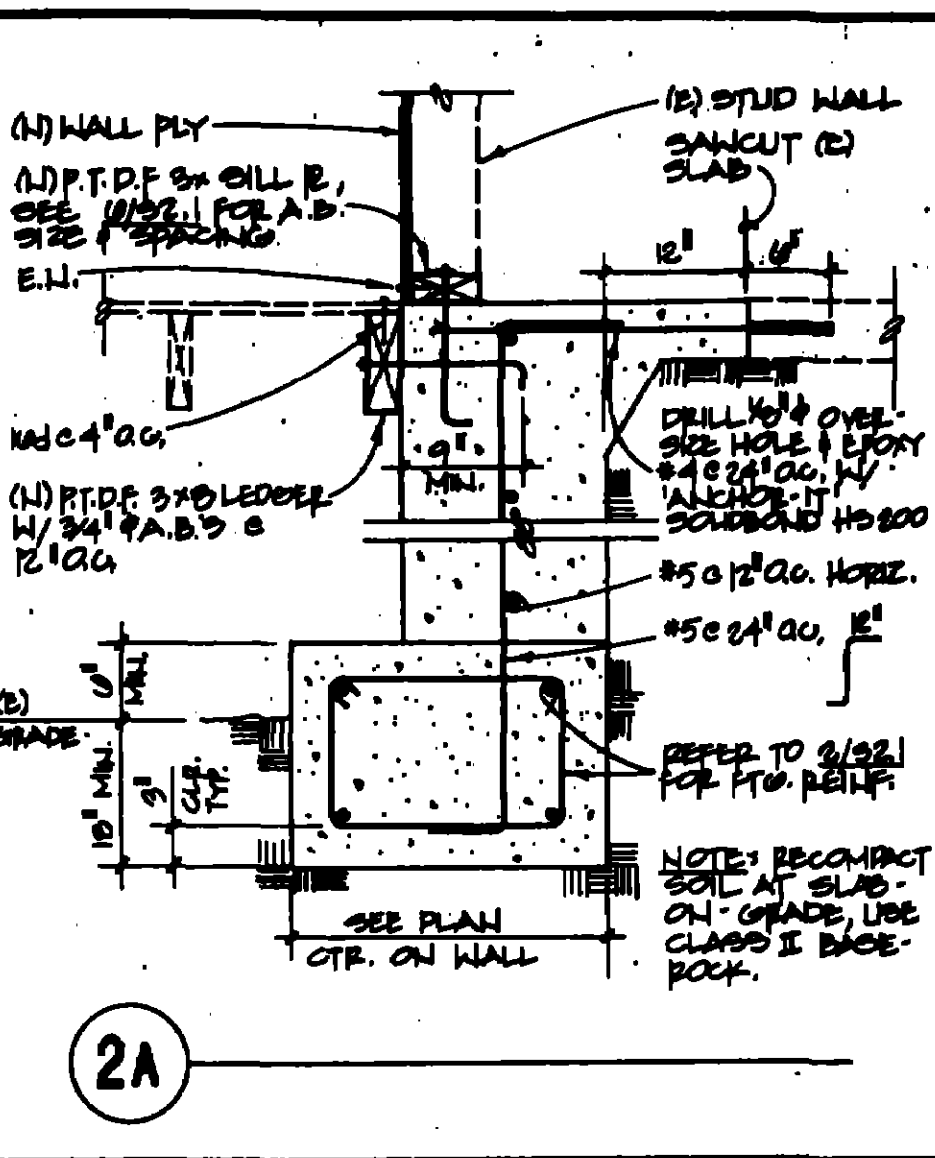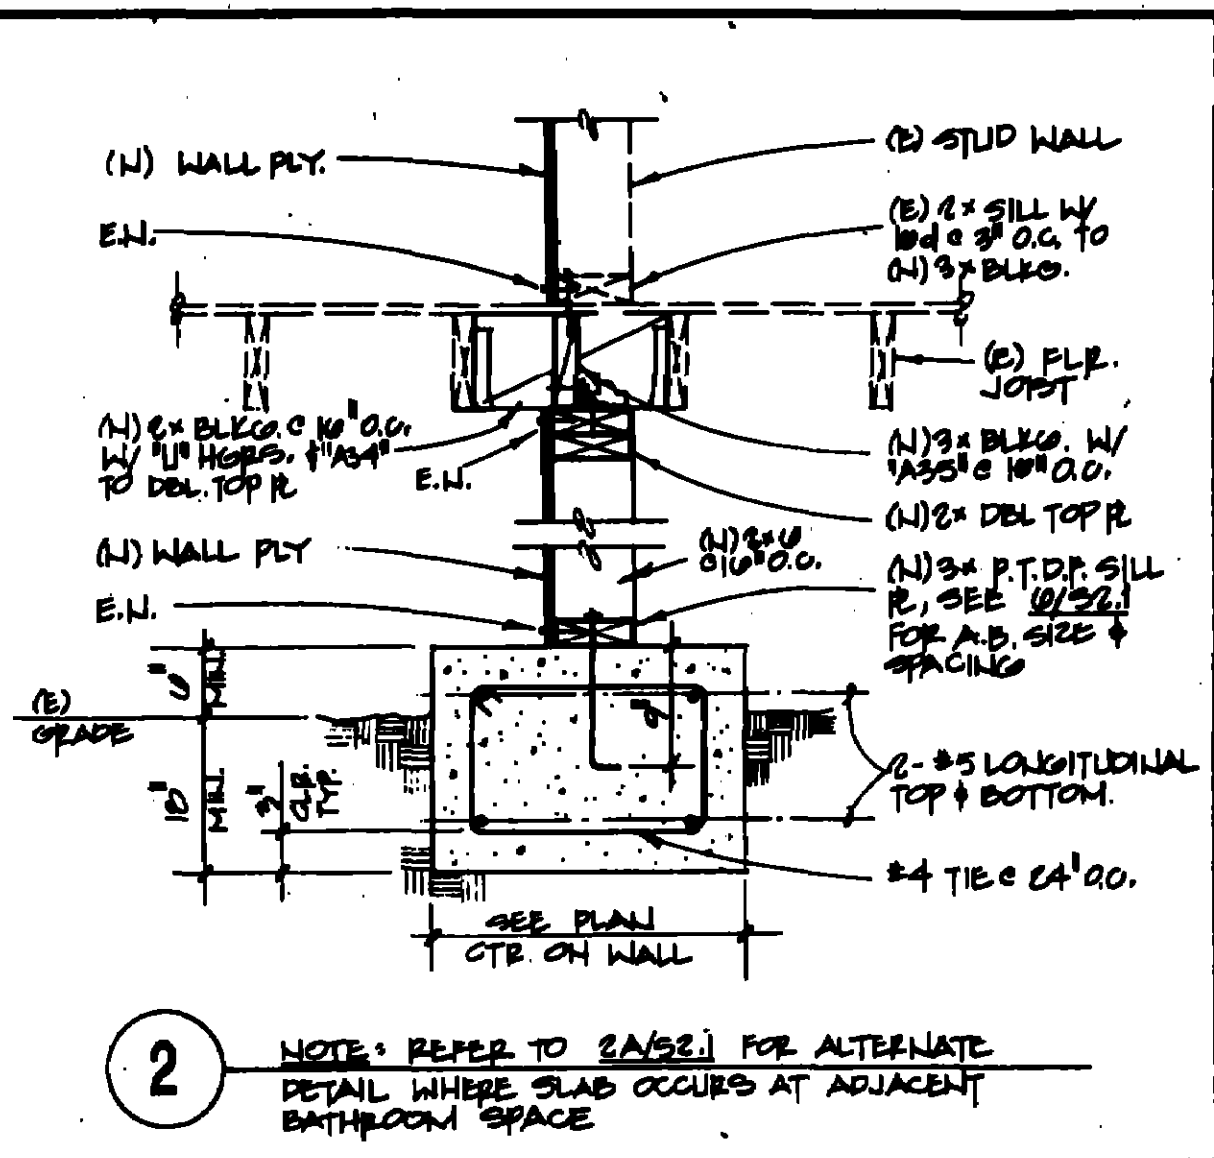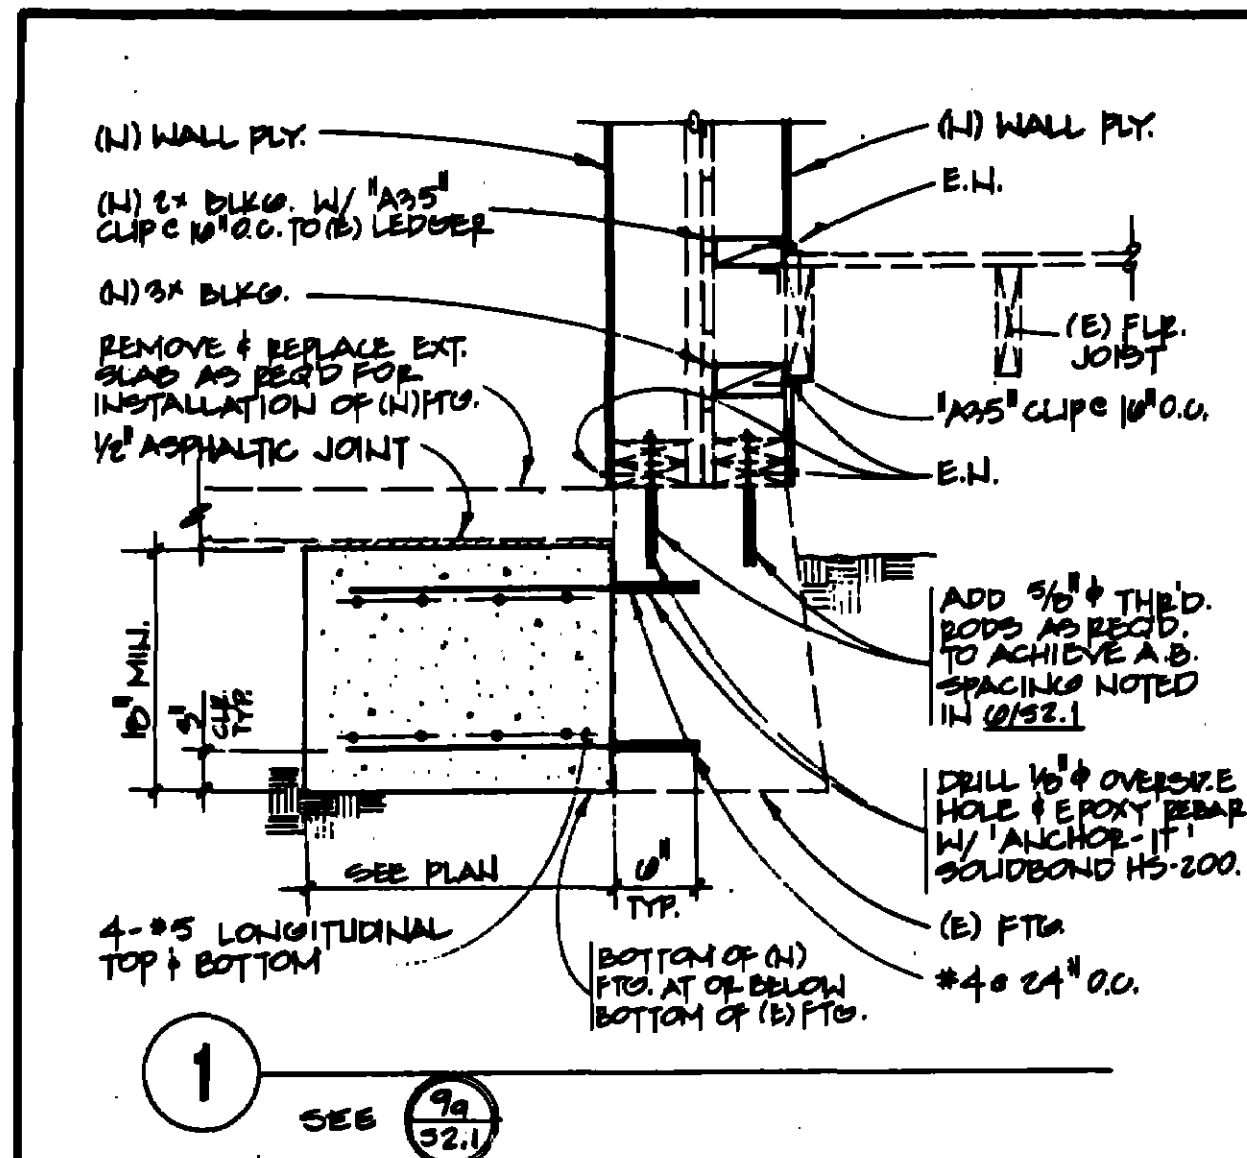

16/32" STRUCT. I PLY.




10d NAIL SPACING

MARK	PANEL	FIELD	REMARKS	SIZE & SPACING
◇	6" O.C.	12" O.C.		10d O.C.
◆	4" O.C.	12" O.C.		10d O.C.

NOTES:

- FOR STUDWALL BOTTOM PLATE ANCHOR BOLT SPACING NOT REFERENCED IN SCHEDULE, USE 3/8" A.B.S. @ 40" O.C.
- EDGE NAIL PLYWOOD TO POST W/ HOLDOWN.
- 10d NAILS SHALL HAVE A MINIMUM PENETRATION OF 1 1/2" INTO STUDS AND POSTS.

6 SHEARWALL SCHEDULE

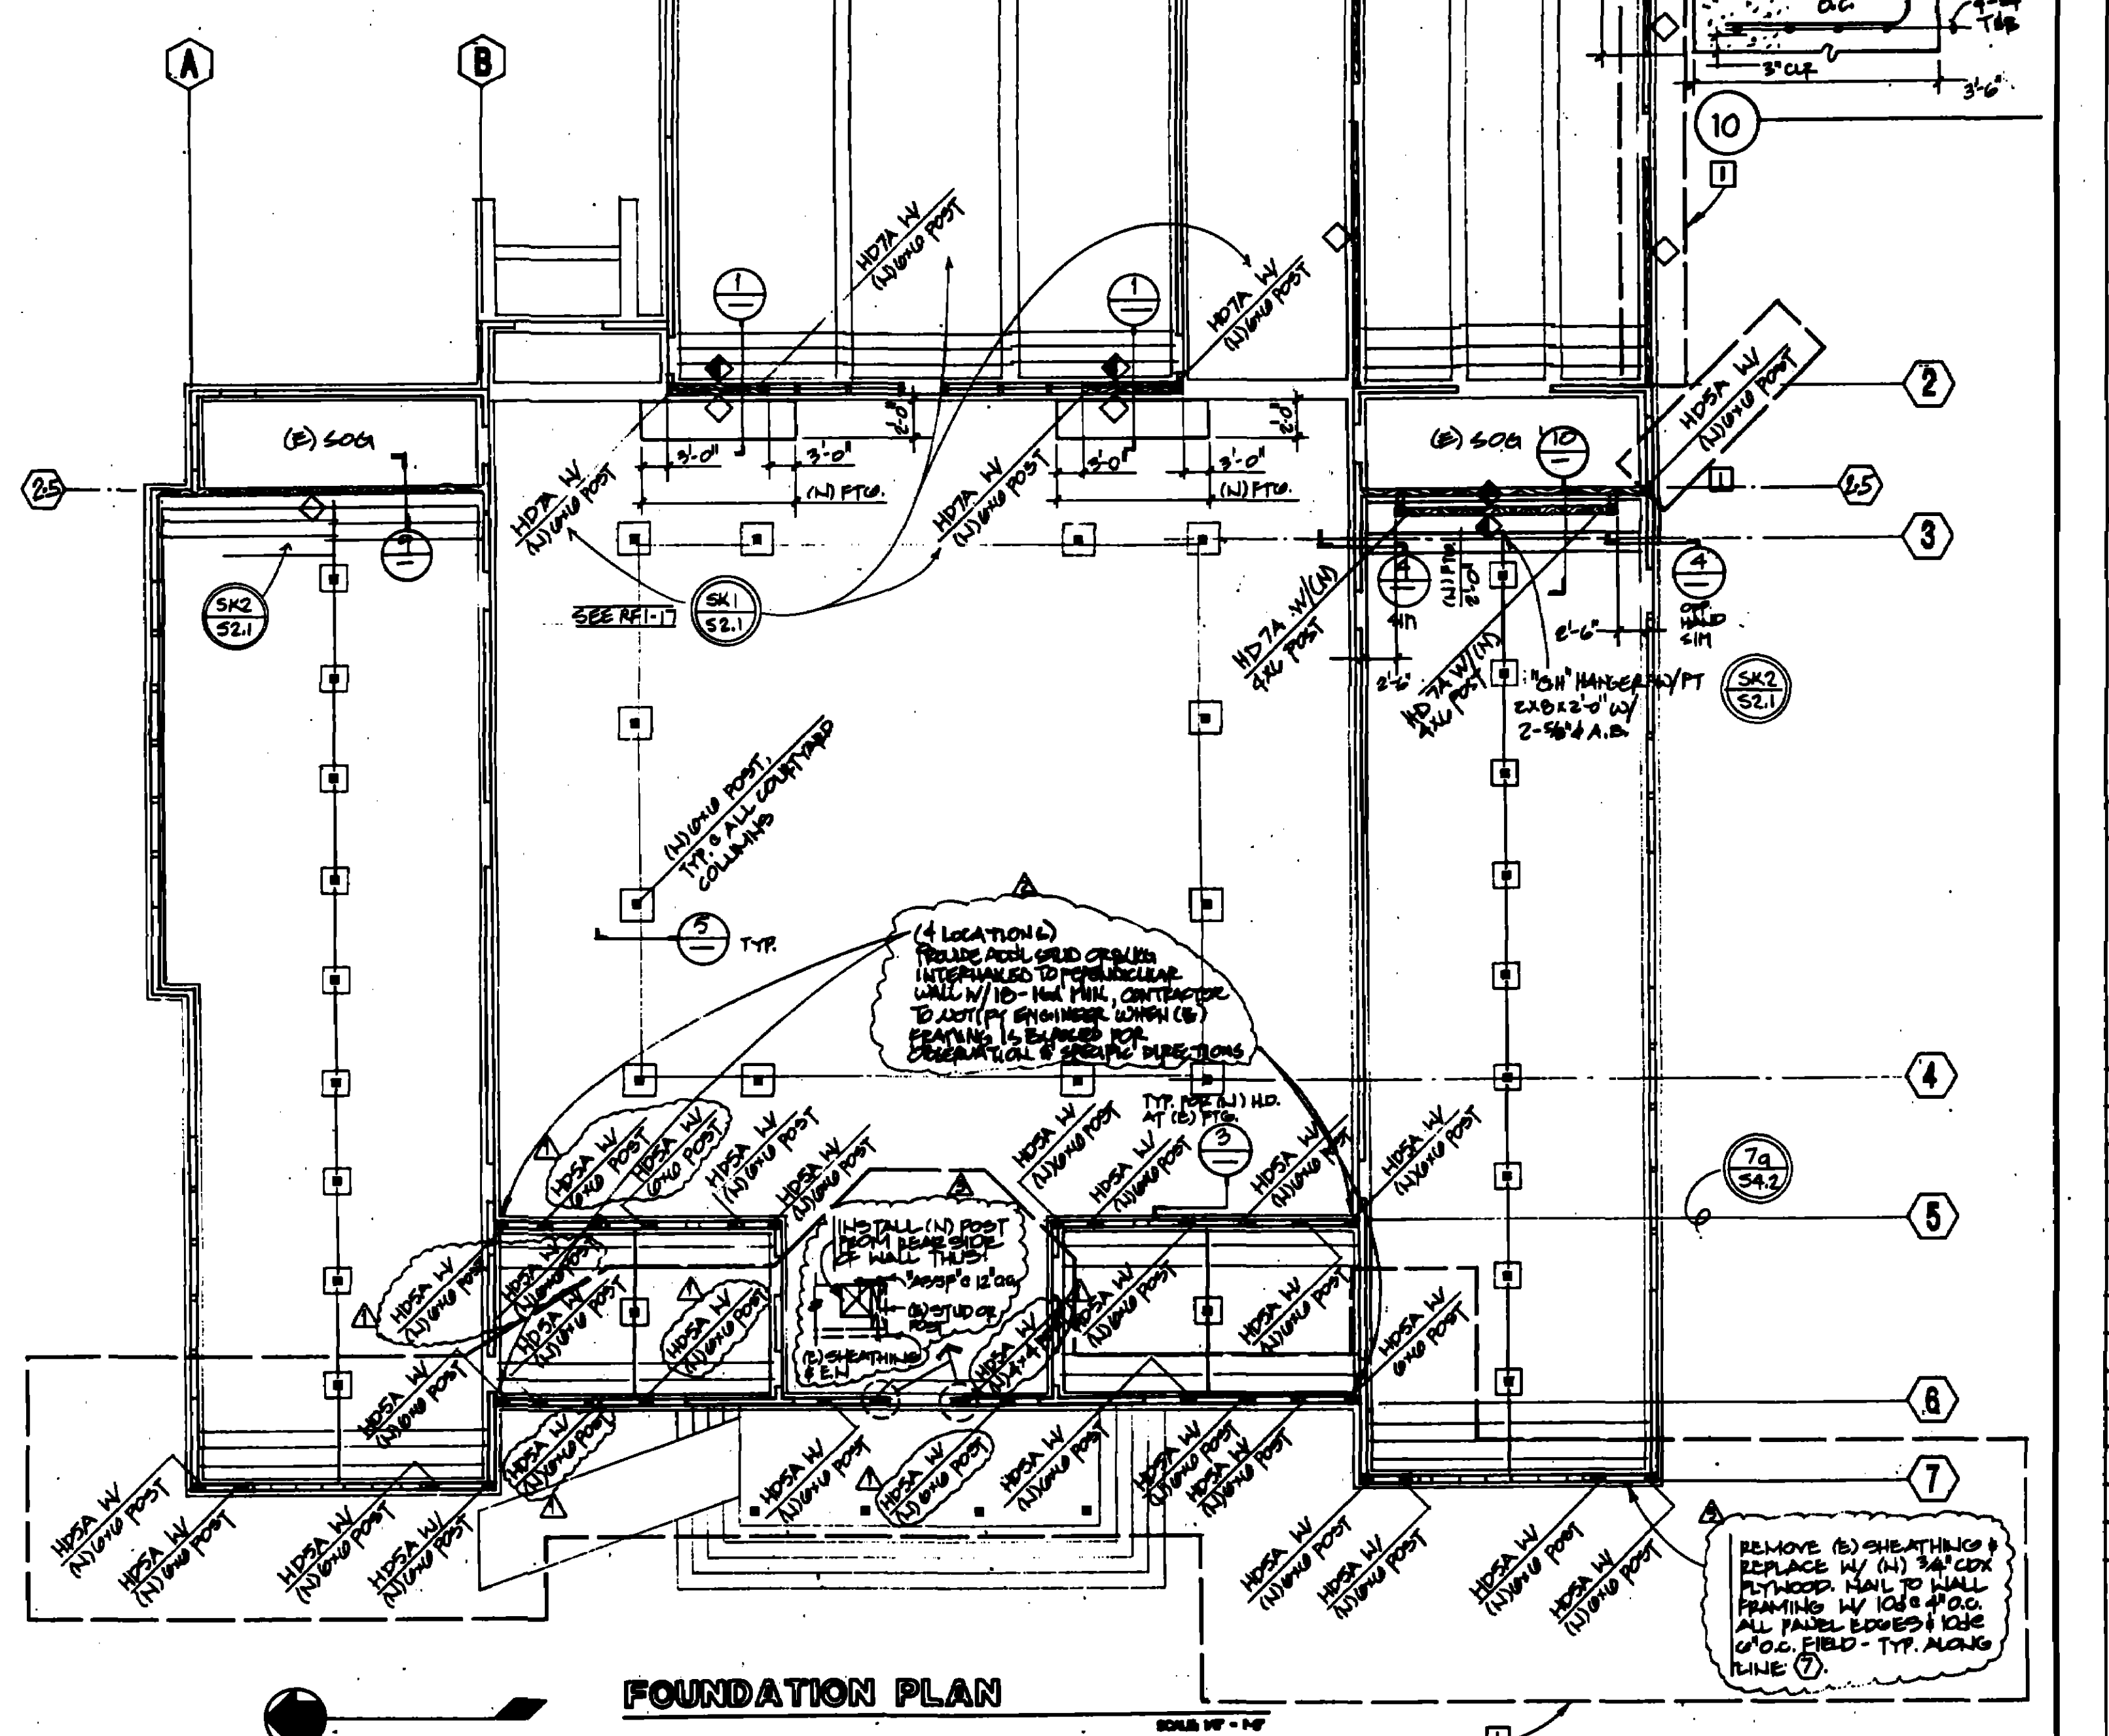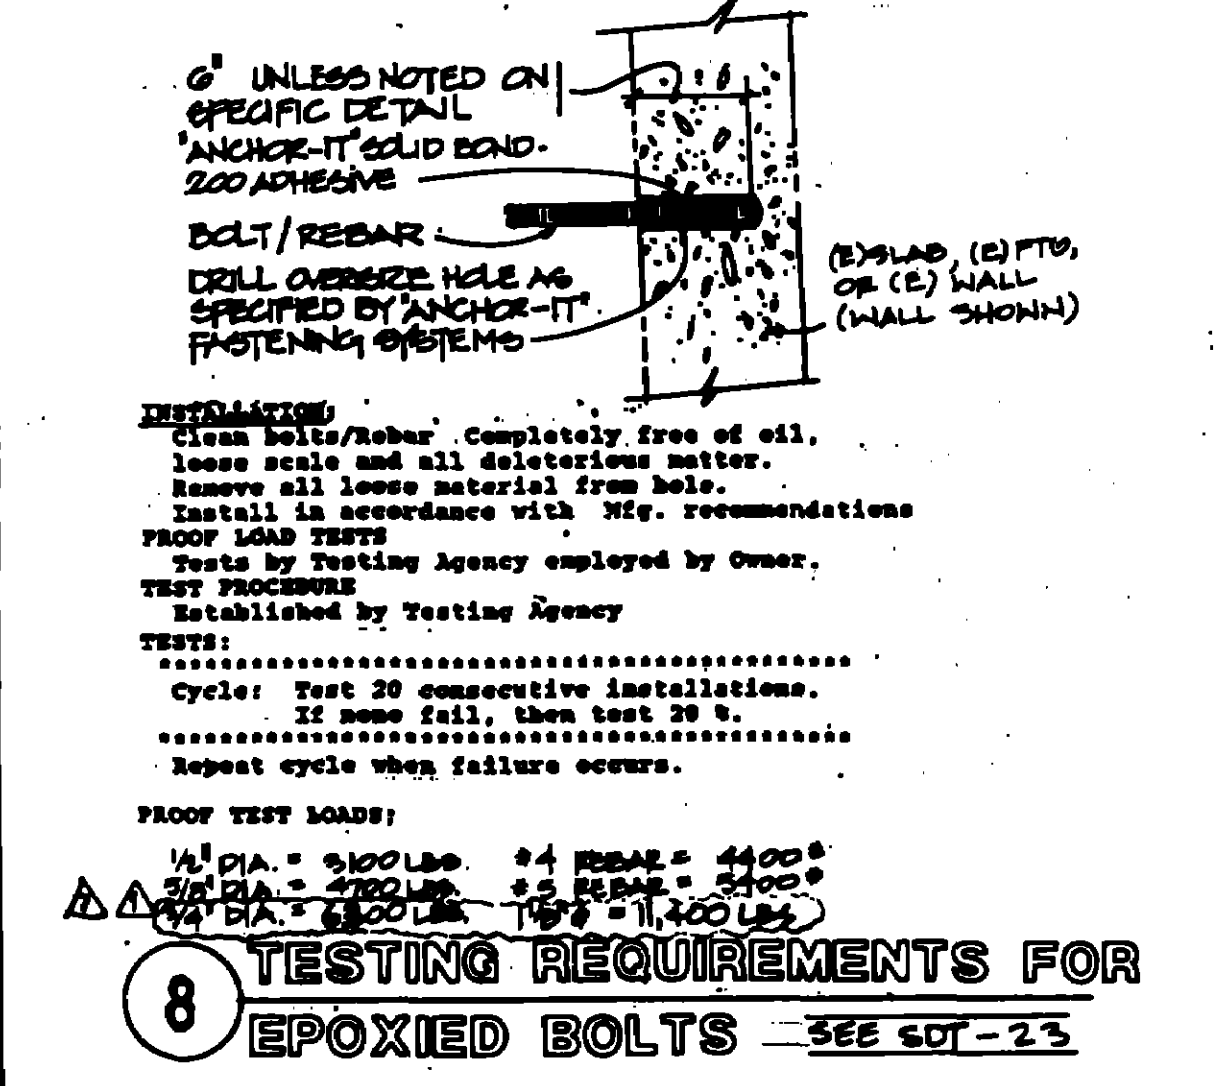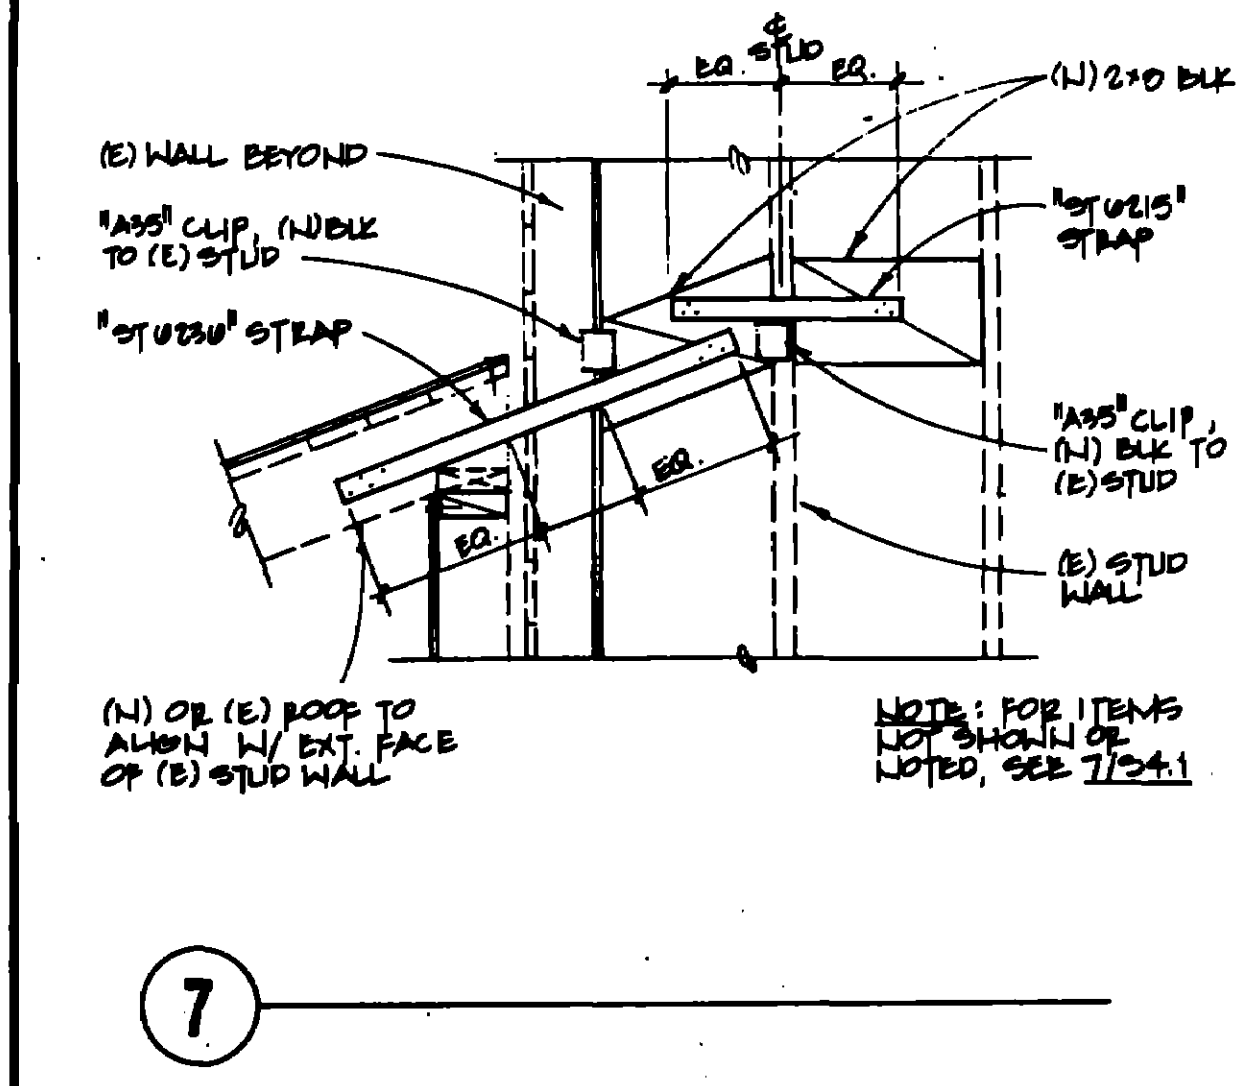

- FOUNDATION PLAN**
- LEGEND**
- PHASE 1 WORK IN THIS AREA - DO NOT INCLUDE IN PHASE 2.
- RECORD DRAWING 4-1-83**
- | REVISION | DATE |
|----------|----------|
| 1 | 10-24-90 |
| 2 | 11-2-90 |
| 3 | 11-10-90 |
| 4 | 10-22-91 |
| 5 | 12/1/91 |
| 6 | 2/10/92 |
- FOUNDATION PLAN DETAILS**
- TESTING REQUIREMENTS FOR EPOXIED BOLTS**
- NOTES:**
- WHERE NEW FOOTINGS ADJ. EXISTING FOOTINGS, THE BOTTOM OF THE NEW FOOTING SHALL BE AT THE SAME ELEVATION AS OR BELOW THE BOTTOM OF THE EXISTING FOOTING.
 - AT EXISTING WOOD STUD WALLS WHERE INDICATED ON PLAN, REMOVAL OF EXISTING STUD WALLS SHALL BE DONE IN ACCORDANCE WITH THE REMOVAL OF EXISTING STUD WALLS. REMOVAL OF EXISTING STUD WALLS SHALL BE DONE IN ACCORDANCE WITH THE REMOVAL OF EXISTING STUD WALLS. REMOVAL OF EXISTING STUD WALLS SHALL BE DONE IN ACCORDANCE WITH THE REMOVAL OF EXISTING STUD WALLS.
 - EXISTING DATA WAS TAKEN FROM FIELD OBSERVATIONS. THE CONTRACTOR SHALL FIELD VERIFY ALL EXISTING CONDITIONS PRIOR TO PROCEEDING WITH THE WORK.
 - THE REMOVAL, CUTTING, DRILLING, ETC., OF EXISTING WORK SHALL BE PERFORMED WITH CARE AND SHALL BE DONE IN ACCORDANCE WITH THE REMOVAL OF EXISTING STUD WALLS. REMOVAL OF EXISTING STUD WALLS SHALL BE DONE IN ACCORDANCE WITH THE REMOVAL OF EXISTING STUD WALLS. REMOVAL OF EXISTING STUD WALLS SHALL BE DONE IN ACCORDANCE WITH THE REMOVAL OF EXISTING STUD WALLS.

STRUCTURAL ENGINEERING

7770 ZAMBER ROAD
SUITE 103
SAN JOSE
CALIFORNIA 95128

408-438-8200

MILITAS SENIOR CENTER PHASE 2

50 North Main
Milpitas, California
Project 9368

LEGEND

□ PHASE 1 WORK IN THIS AREA - DO NOT INCLUDE IN PHASE 2.

RECORD DRAWING 4-1-83

REVISION	DATE
1	10-24-90
2	11-2-90
3	11-10-90
4	10-22-91
5	12/1/91
6	2/10/92

FOUNDATION PLAN DETAILS

TESTING REQUIREMENTS FOR EPOXIED BOLTS







NOTES:

- WHERE NEW FOOTINGS ADJ. EXISTING FOOTINGS, THE BOTTOM OF THE NEW FOOTING SHALL BE AT THE SAME ELEVATION AS OR BELOW THE BOTTOM OF THE EXISTING FOOTING.
- AT EXISTING WOOD STUD WALLS WHERE INDICATED ON PLAN, REMOVAL OF EXISTING STUD WALLS SHALL BE DONE IN ACCORDANCE WITH THE REMOVAL OF EXISTING STUD WALLS. REMOVAL OF EXISTING STUD WALLS SHALL BE DONE IN ACCORDANCE WITH THE REMOVAL OF EXISTING STUD WALLS. REMOVAL OF EXISTING STUD WALLS SHALL BE DONE IN ACCORDANCE WITH THE REMOVAL OF EXISTING STUD WALLS.
- EXISTING DATA WAS TAKEN FROM FIELD OBSERVATIONS. THE CONTRACTOR SHALL FIELD VERIFY ALL EXISTING CONDITIONS PRIOR TO PROCEEDING WITH THE WORK.
- THE REMOVAL, CUTTING, DRILLING, ETC., OF EXISTING WORK SHALL BE PERFORMED WITH CARE AND SHALL BE DONE IN ACCORDANCE WITH THE REMOVAL OF EXISTING STUD WALLS. REMOVAL OF EXISTING STUD WALLS SHALL BE DONE IN ACCORDANCE WITH THE REMOVAL OF EXISTING STUD WALLS. REMOVAL OF EXISTING STUD WALLS SHALL BE DONE IN ACCORDANCE WITH THE REMOVAL OF EXISTING STUD WALLS.

2 - 913









2-9/3

54.1
20/24

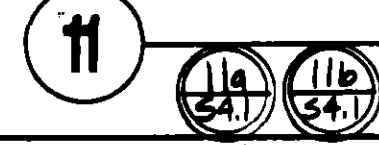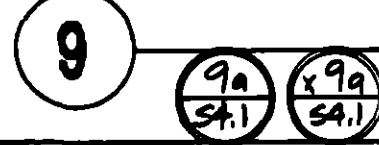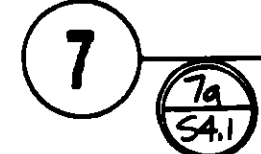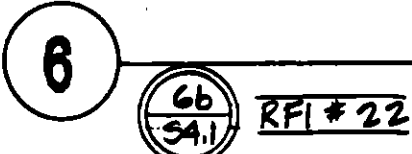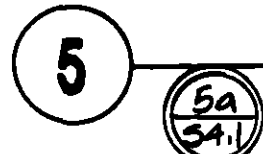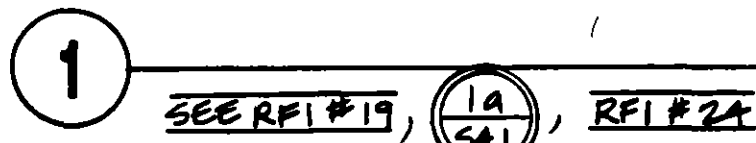

2 - 913

2-9/3

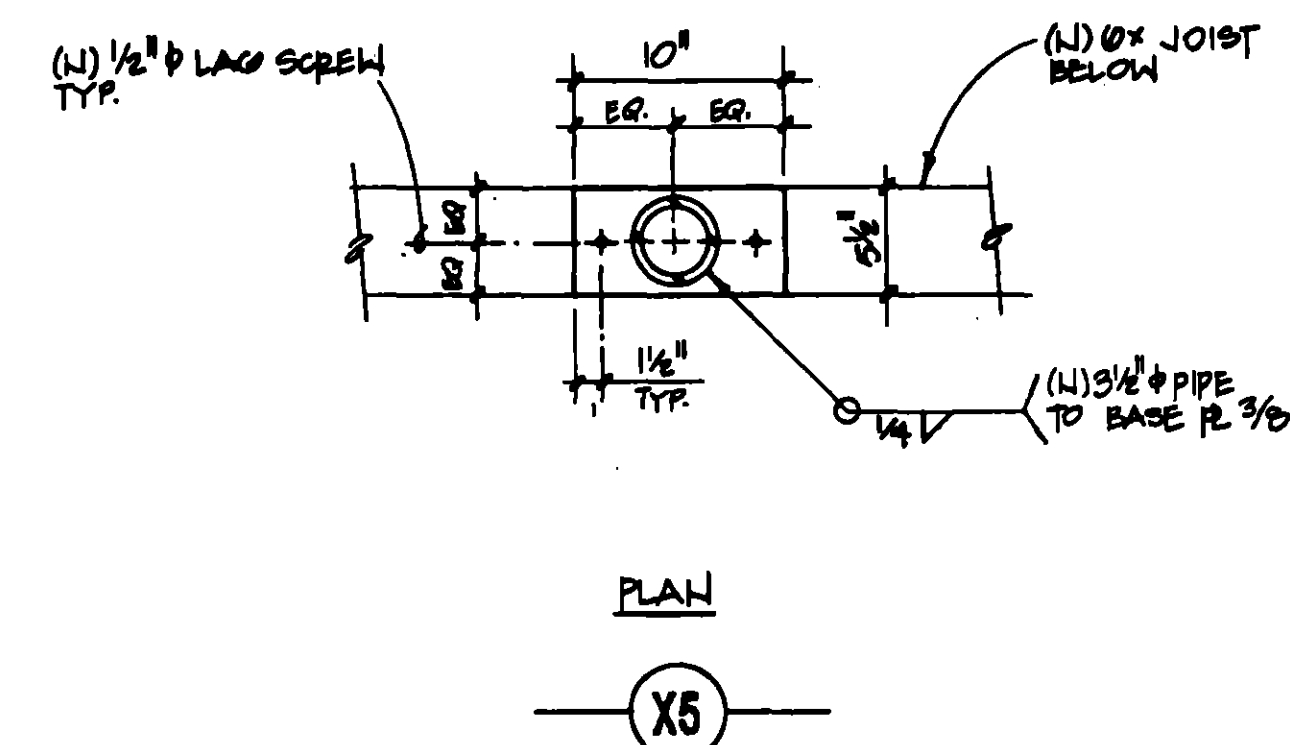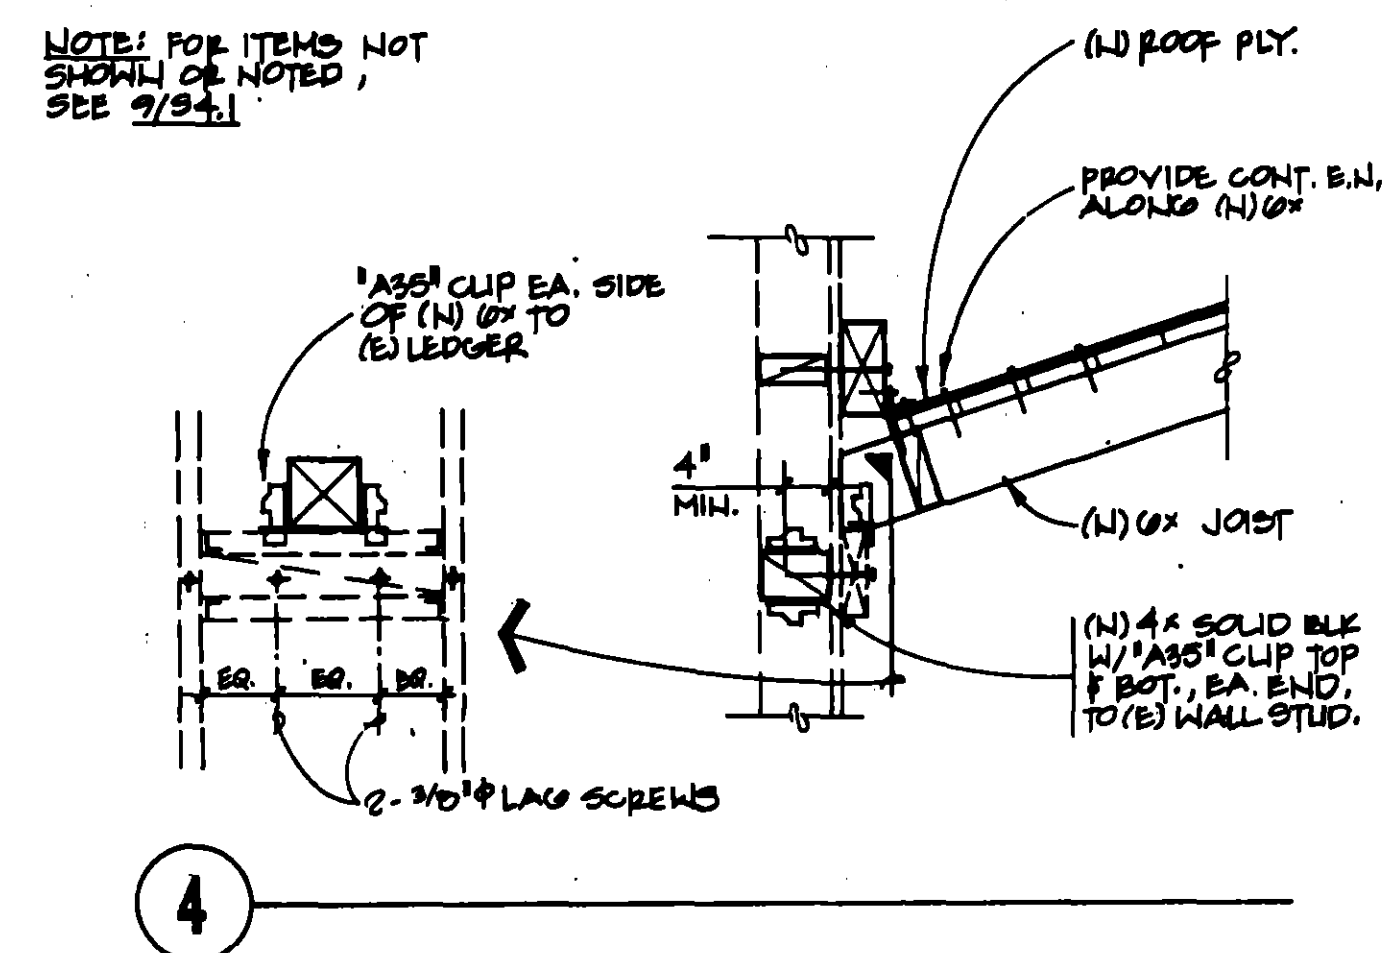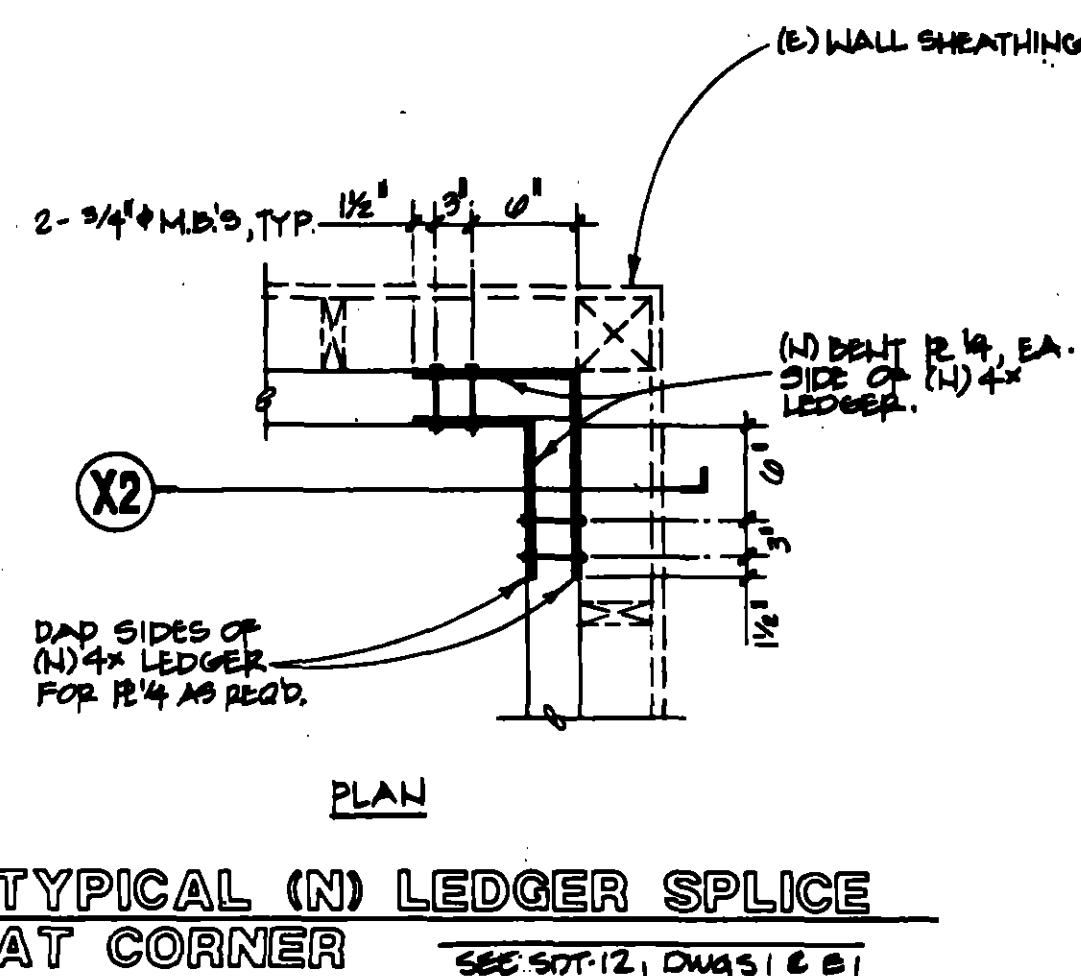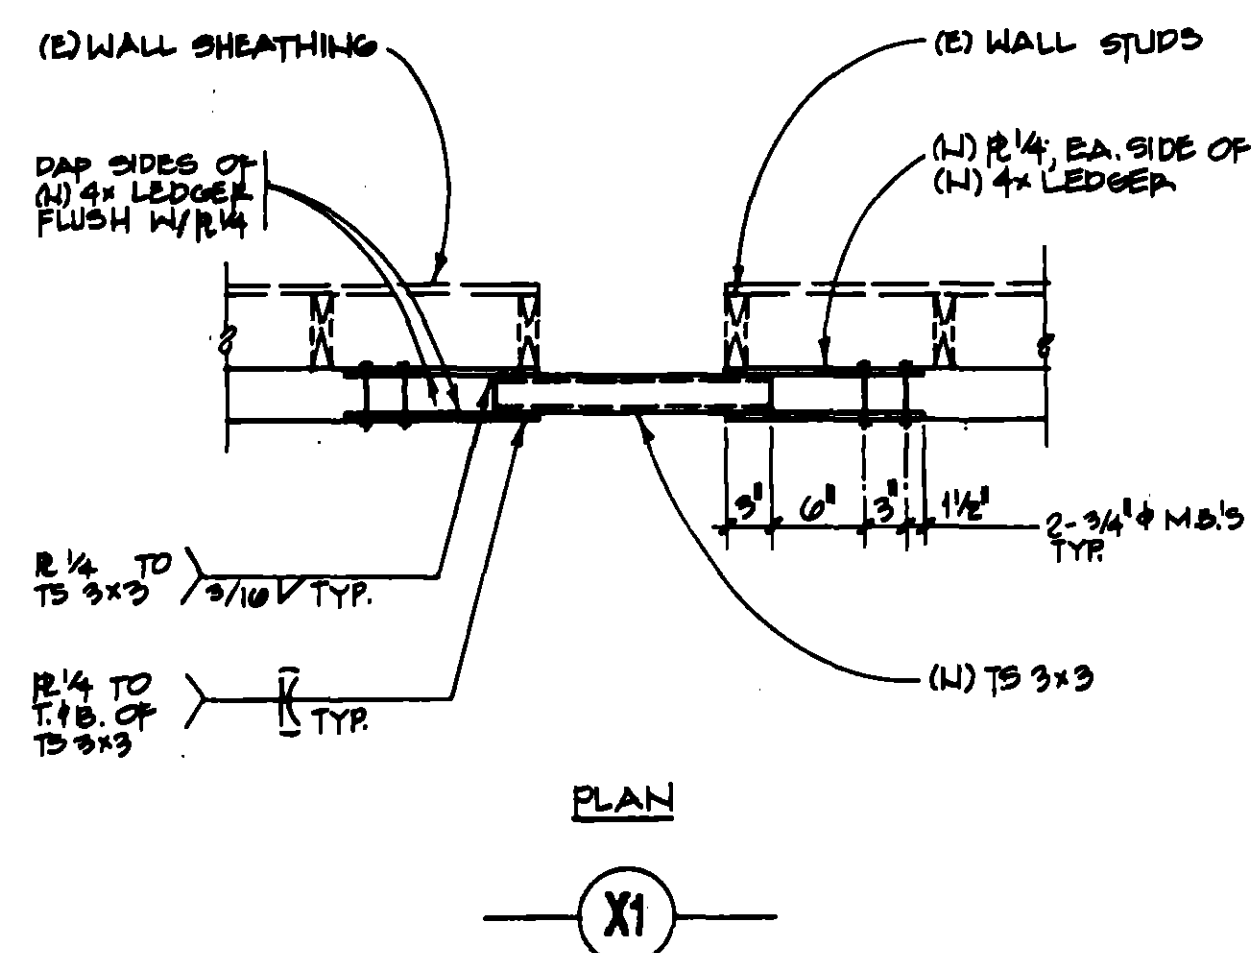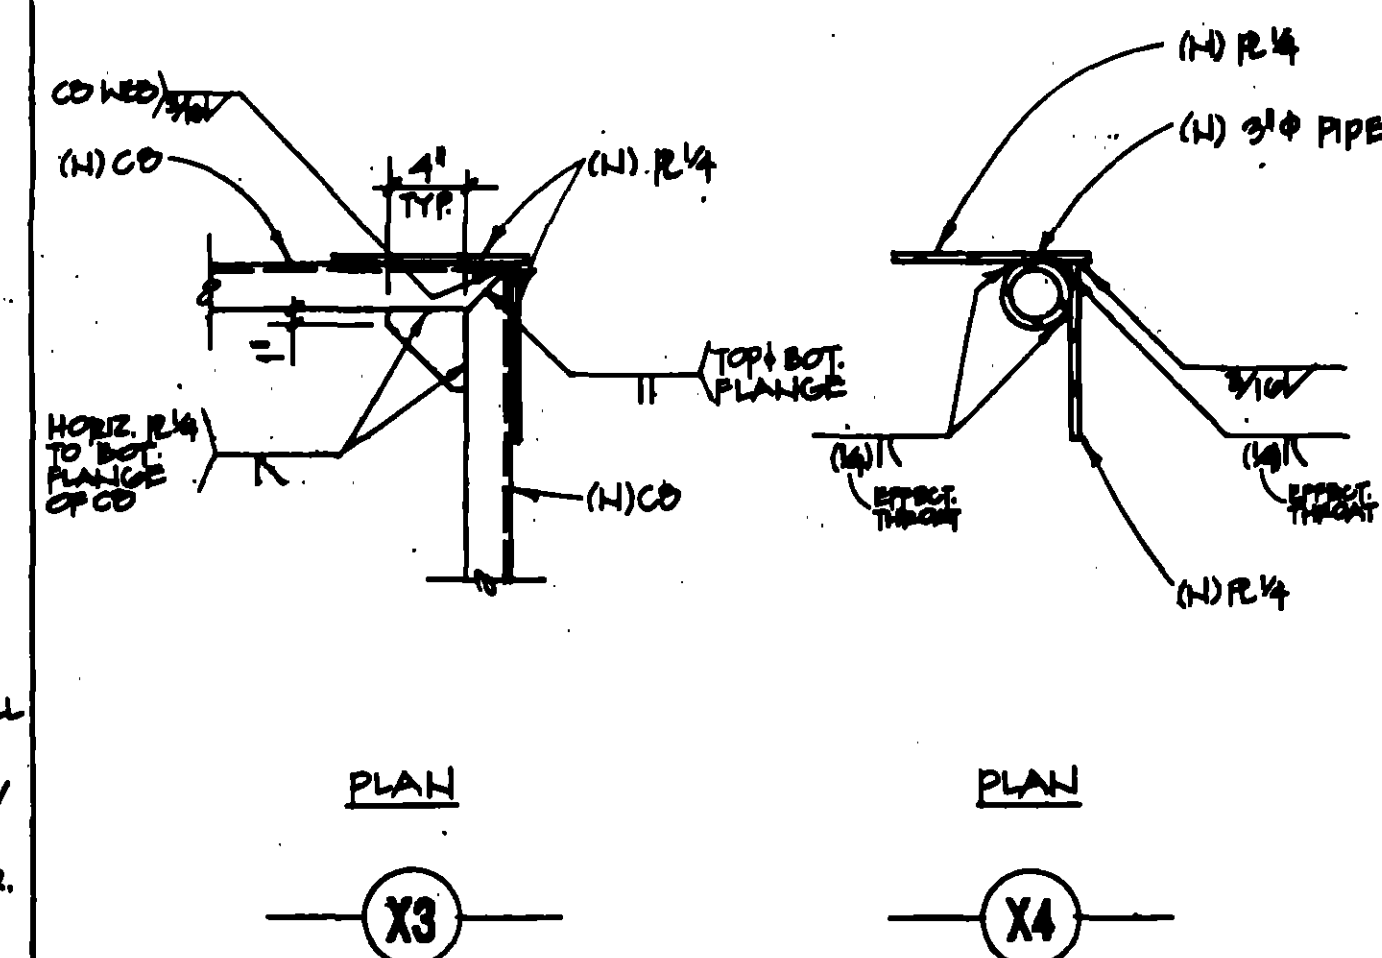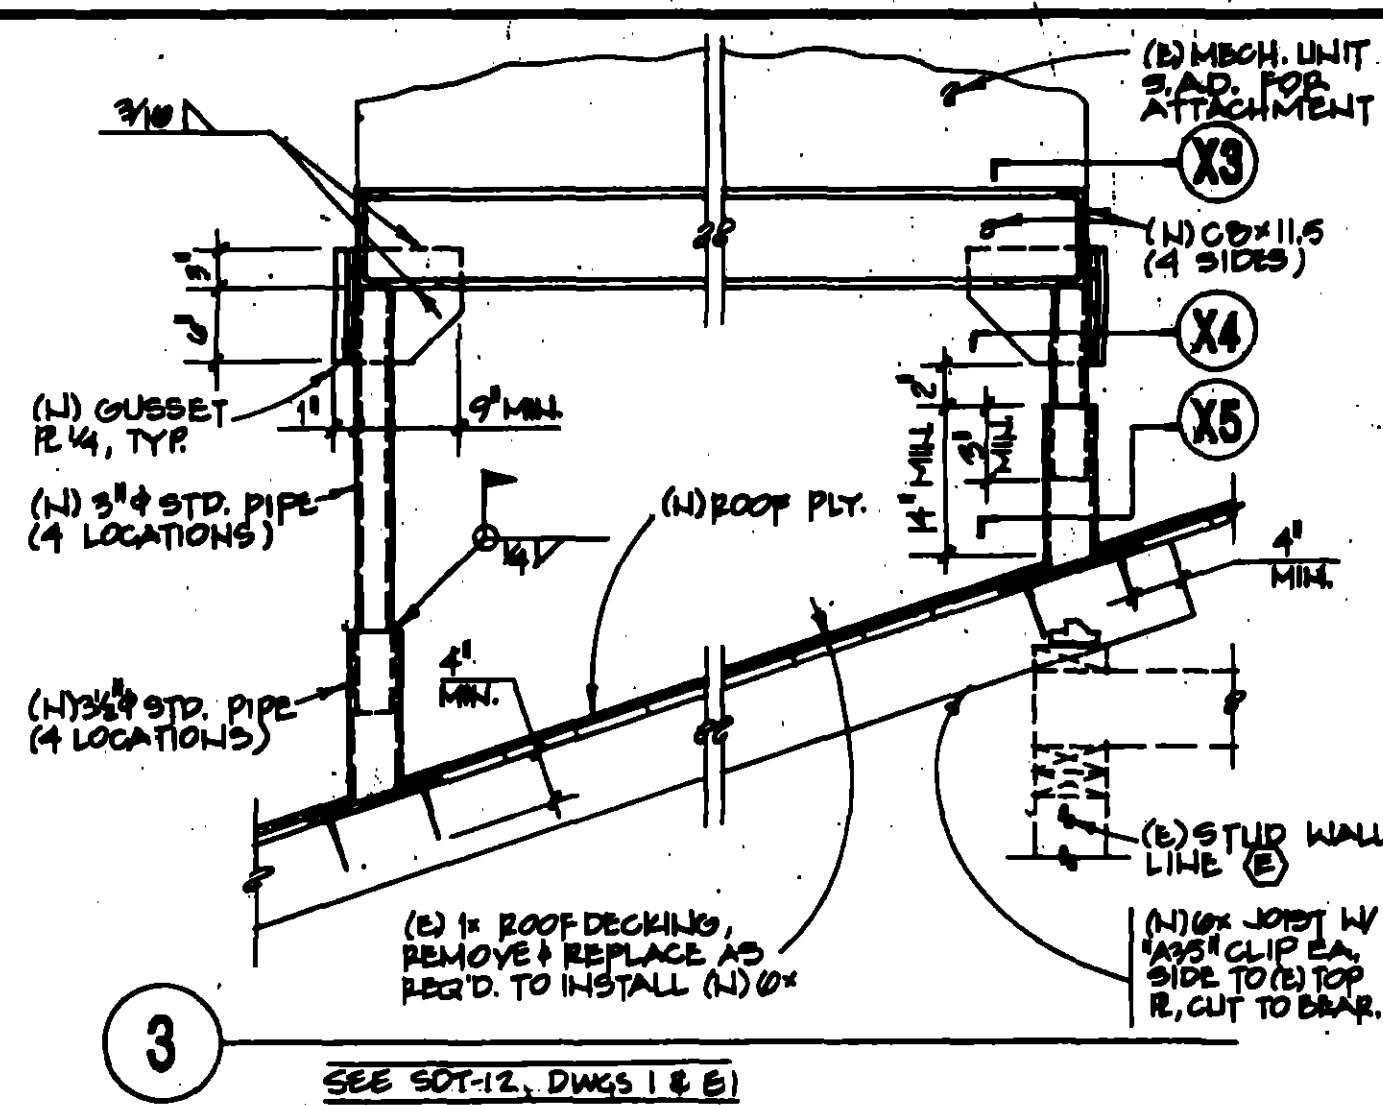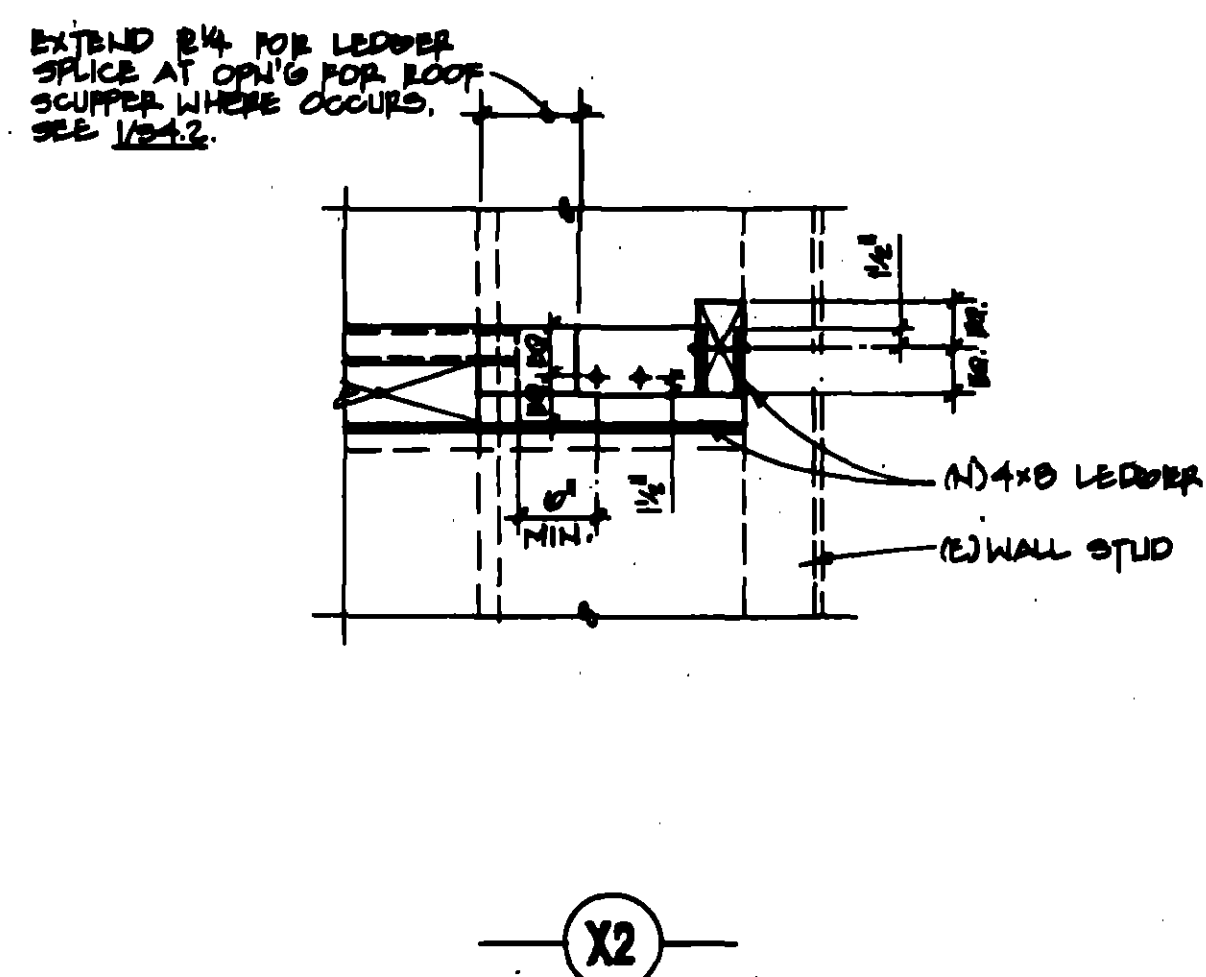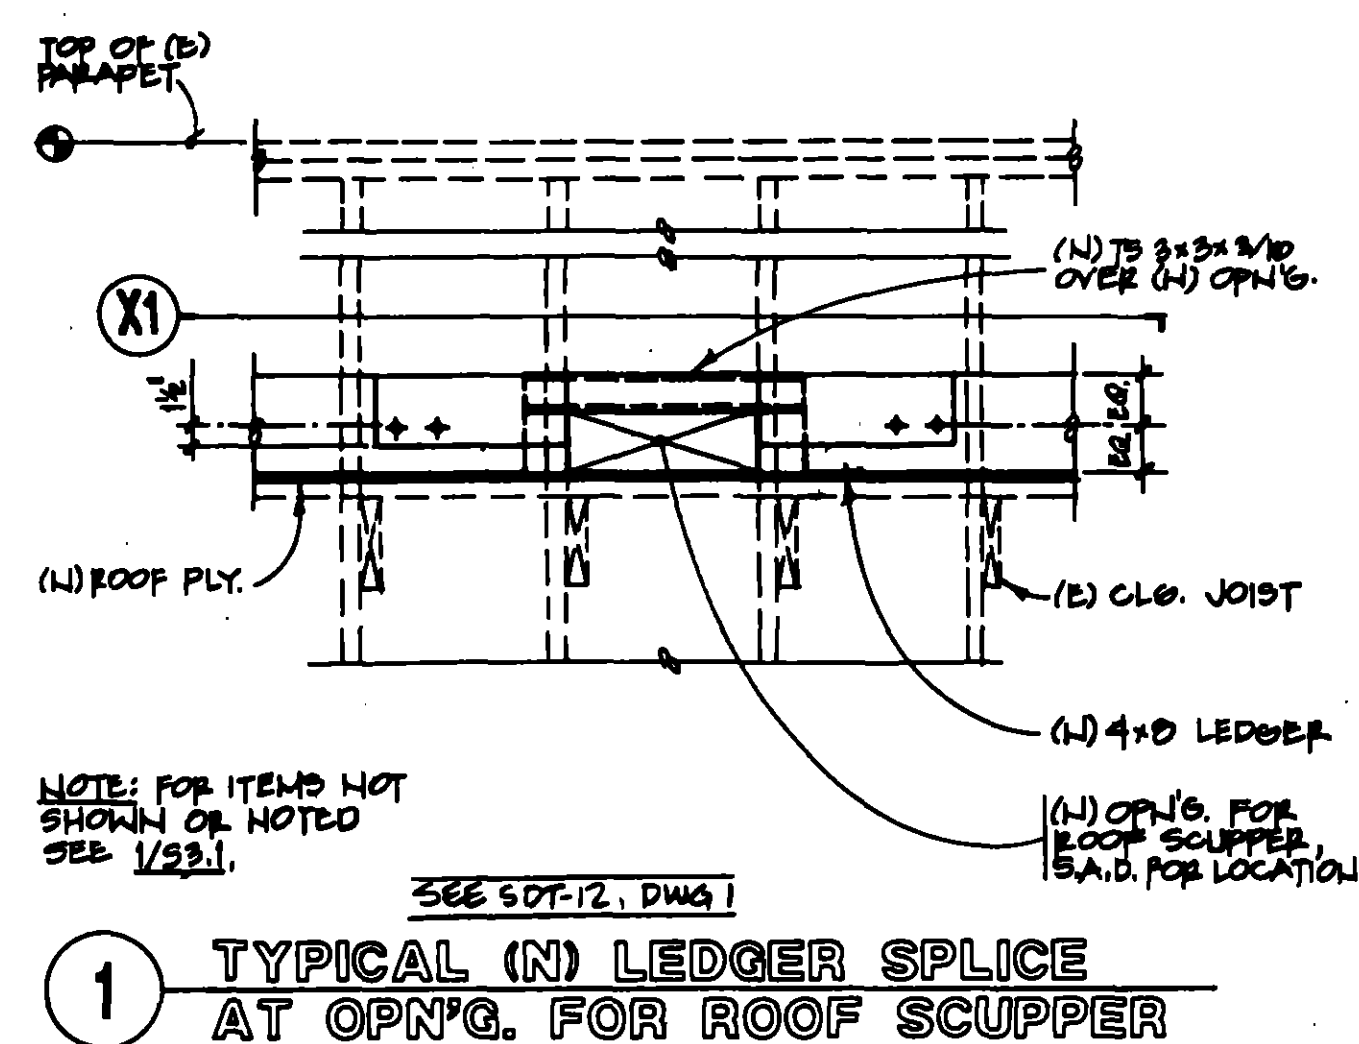

SEE 8 1/2" x 11" SKETCHES

Boley

**STRUCTURAL
ENGINEERING**

**1716 ZANKER ROAD
SUITE 103
SAN JOSE
CALIFORNIA 95112**

498-438-0200

MILPITAS SENIOR CENTER PHASE 2

160 North Main
Milpitas, California
Project 3360

RECORD DRAWING
4-1-93

⚠ PHASE 2	7-17-91
⚠ PHASE 2 ISSUE for REVIEW	10-22-91
⚠ ISSUED for BID	12/4/91

REVISION	DATE
----------	------

FRAMING DETAILS

JOB# : 90-061

DRAWN : MC

DATE : 7-17-91

SCALE : NONE

S4.2

2 - 913

55.1
22/24
2-9/3

SECTION 01400 - TESTING AND INSPECTIONS

PART 1 - GENERAL

1.01 SCOPE OF WORK
Furnish all labor, materials, equipment and services necessary to provide all testing and inspection services, required under pertinent sections of these specifications.

1.02 QUALITY
A. Testing laboratory shall be qualified in accordance with ASTM E 329 "Recommended Practice for Testing Agencies for Concrete and Steel Used in Construction".

B. Personnel for inspection and testing shall be thoroughly trained and experienced in the necessary skills, completely familiar with the requirements specified, pertinent portions of the contract documents, and standards for inspecting and testing for the required purposes.

PART 2 - PRODUCTS

2.01 MATERIALS REQUIRING TESTS INCLUDING BUT NOT LIMITED TO:
A. Testing of unidentified structural steel and reinforcing steel.
B. Inspection of all welding.
C. Concrete sampling and taking cylinders.
D. Concrete compression tests.
E. Concrete mix design.
F. Inspection of concrete reinforcement placement.
G. Inspection of concrete placement.
H. Testing and inspections of glued laminated wood members.

2.02 TEST REPORTS
A. Distribution
The testing agencies shall report the results of all tests directly and simultaneously to the Owner, Architect, Contractor, and Structural Engineer.

B. Responsibility: The reports shall be signed by a Professional Engineer registered to practice in the appropriate discipline.

2.03 SCHEDULE FOR TESTING

A. Establishing Schedule
1. By advance discussion with the testing laboratory selected by the Owner, determine the time required for the laboratory to perform its tests and to issue its findings.
2. Provide all required time within the construction schedule.
B. Revising Schedule
When changes of construction schedule are necessary during construction, coordinate all such changes of schedule with the testing laboratory as required.
C. Adherence to Schedule
When the testing laboratory is ready to test according to the determined schedule but is prevented from testing or taking specimens due to incompleteness of the work, all extra costs for testing attributable to the delay may be back-charged to Contractor and shall not be borne by the Owner.

PART 3 - EXECUTION

3.01 TESTING LABORATORY DUTIES AND LIMITATIONS OF AUTHORITY

A. Testing Laboratory Duties
1. Cooperate with the Architect and Contractor.
2. Provide qualified personnel promptly on notice.
3. Perform specified sampling, testing and inspecting of materials for compliance with requirements of Contract Documents.
4. Promptly notify Architect and Contractor of any irregularities or deficiencies of work which are discovered during the construction.
5. Certify in writing to the Architect and the Owner that the test results meet or exceed the Specification requirements.
B. The testing laboratory is not authorized to:
1. Release, revoke, alter or enlarge on requirements of Contract Documents.
2. Approve or accept any portion of the work not in conformance with specified requirements.
3. Perform any of the Contractor's duties.
C. Persons Authorized to Test
The following shall be the only persons authorized to order tests specified:
1. The Owner and his duly authorized representative.
2. The Architect and his duly authorized representative.
3. The Building Department Inspector, but only upon notice to the Architect's representative that he intends to order additional testing.

3.02 PAYMENT FOR TESTS

A. Owner Payment
Initial tests of items in scope of work will be paid by the Owner.
B. Retest Payment
Retest payment by Owner for the first test of material and workmanship, and for authorized retesting where the results of the retests are satisfactory. If the Contractor corrects work before it has been inspected and tested, the costs for retesting defective materials and workmanship, together with the cost of replacement of defective work shall be borne by the Contractor.

3.03 COORDINATION
The Contractor shall cooperate fully with the testing laboratory's personnel and with special inspectors in inspecting any part of the construction and in taking any samples of materials required to be tested. The Contractor shall provide access to the work. The Contractor's personnel shall furnish and cut or prepare all samples in the presence of either the testing laboratory personnel or the special inspectors and secure the witness's initial on each sample prepared. Notify the testing laboratory to send a bonded messenger to pick up the initial samples the same day the samples were prepared. The Contractor shall alert the testing laboratory 24 hours in advance as to the time and location of the required sampling, tests and inspections so as to not delay the work of the project, and make sure that the required sampling, tests and inspections are promptly completed.

3.04 TAKING SPECIMENS
All specimens and samples for testing, unless otherwise provided in these Contract Documents, will be taken by the testing laboratory; all sampling equipment and personnel will be provided by the testing laboratory; and all deliveries of specimens and samples to the testing laboratory will be performed by the testing laboratory.

SECTION 03100 - CONCRETE FORMWORK

PART 1 - GENERAL

1.01 SCOPE OF WORK

Furnish all labor materials, equipment and services necessary to provide all concrete formwork, complete in place, as shown on the drawings or specified herein.

1.02 REFERENCE STANDARDS
A. American Concrete Institute Standard ACI 347 - "Recommended Practice for Concrete Formwork" and ACI 310 "Building Code Requirements for Reinforced Concrete", latest edition.
B. West Coast Lumber Inspection Bureau "Standard Grading Rules for West Coast Lumber", current edition.
C. Uniform Building Code, current edition.
D. Product Standard PS-1.

SECTION 03100 - CONCRETE FORMWORK (cont.)

1.03 SUBMITTALS

A. Formwork design submittals are not required on this project.
B. The form layout, snap tie locations and construction joint layout shown on drawings is for design compliance only. The contractor shall be responsible for dimensions at job site, fabrication process and dimensions of construction and structural requirements of formwork.

1.04 COORDINATION

A. All pipe sleeves, anchors and bolts, including those for angle frames, insert supports, ties and other material in connection with concrete construction, shall be secured in position before the concrete is placed.
B. The contractor shall obtain information and instructions from other trades and suppliers in ample time to schedule and coordinate the installation of items furnished by them to be embedded in concrete so that provisions for their work can be made without delaying the project.
C. Cutting and/or patching made necessary by failure of delay in complying with these requirements shall be made at no cost to the Owner.

1.05 PRODUCT HANDLING

A. Protection: Protect formwork materials before, during and after installation and protect the installed work and materials of all other trades.
B. Repairs: In the event of damage, immediately make all repairs and replacements necessary to the acceptance of the Architect at no additional cost to the Owner.

PART 2 - PRODUCTS

2.01 MATERIALS

A. Earth Forms: Unless otherwise indicated or required by the Structural Drawings, concrete for grade beams, footings and similar below-grade structures may be placed directly against vertical excavated surfaces provided the material will stand without caving and provided that minimum reinforcing steel clearances indicated on drawings are maintained and suitable provisions are taken to prevent revealing of top edges or sloping of loose material from walls of excavation and shall be made with a neat cut. Concrete which is exposed to view on exterior shall be formed to a minimum depth of 6" below finished grade.
B. WOOD FORMS
1. Exposed Concrete Not Otherwise Noted or Specified: DRYA graded RDO (High Density Overlay) Plyform, Class 1 or II (as per strength and tolerance requirements), Exterior, each piece grade marked. Exception: Edge forms for slabs on grade.
2. All other surfaces: metal, spreader type, removable to 1" from concrete face. Wire ties and wood spreaders will not be allowed except that such devices may be permitted for footings, shallow foundations and similar other totally concealed below grade surfaces upon specific approval of Architect. Wood spreaders shall not remain in concrete.

2.02 OTHER MATERIALS
All other materials, not specifically described but required for proper completion of concrete formwork, shall be as selected by the Contractor subject to the acceptance of the Architect.

PART 3 - EXECUTION

3.01 GENERAL
Contract forms as specified for the purpose, rigidly constructed and providing for special built-in features and details, as indicated.

3.02 FORMWORK DESIGN

1. Forms shall be designed by a State of California Licensed Civil or Structural Engineer in accordance with the reference standards.
2. Design all forms in strict compliance with ACI 347, latest edition.

3.03 CONSTRUCTION OF FORMS

A. Rigidly support and substantially construct forms; erect plumb, straight and true, in shape, dimensions, and in precise position to form the lines and designs indicated, suitable for removal without injury to concrete. Make forms tight without cracks or holes so as to prevent loss of fine particles from the concrete.
B. Construction Joints: Construction joints shall be in accordance with requirements of Cast-in-place concrete, Division 3. Joints in a continuous line shall be straight and true.
C. Openings: Provide cleanout ports of formwork. Do not fasten the bottom board in wall forms until just prior to placing concrete.
D. Chamfers and Bevels: Provide beveled corners on all external concrete corners by fitting 3/4" triangular strip at angles.
E. Schedules, Schedules, Seats and Pickets: Forms as indicated or required to receive or engage related work. These include provisions for flashings, anchors, etc.
F. Verify dimensions and details. Do not permanently cast wood into concrete, except where wood nailers are specifically indicated.

H. Inspected Items
1. Conduit in slabs on grade: Do not embed piping or electrical conduit in structural concrete unless specifically approved in writing by the Structural Engineer.
2. Anchors and Rough Hardware: Accurately secure so that they will not be displaced during concrete placement and finishing.
I. Form Sealer: Apply form sealer to forms prior to placing reinforcement. Apply in strict conformance with the latest printed recommendations of the sealer manufacturer.
J. Tolerances: The following maximum tolerances shall be allowed for form construction:
1. Supported slabs, beams and wall thickness: +/- 1/4"
2. Wall centerline location: +/- 1/4"
3. Columns: +/- 1/4" in any one story and +/- 1/4" to ground reference point.
4. Slab on grade thickness: +/- 1/2"
5. All other: +/- 1/2"

3.04 REUSE OF FORMS

Clean and repair the surfaces of forms that are to be reused, except that split, frayed, delaminated or otherwise damaged forms shall not be reused. Apply new form coating material to all contact areas. When forms are extended for successive concrete placement, thoroughly clean surfaces and remove fine and laitance.

3.05 REMOVAL OF FORMS

A. The removal of forms and falsework shall be carried out in such a manner as to ensure the complete safety of the structure. Supports shall not be removed until members have sufficient strength to safely support their own weight and any superimposed loading with proper factor of safety.

3.06 CLEAN UP

During the progress of the work, the premises shall be kept free from debris and waste materials resulting from the work of this Section. Upon completion, all surplus materials and debris shall be removed from the site.

SECTION 03200 - REINFORCING STEEL

PART 1 - GENERAL

1.01 SCOPE OF WORK

Furnish all labor, materials, equipment and services necessary to provide all concrete reinforcing steel, complete in place, as shown on the drawings or specified herein.

1.02 QUALITY

A. Qualifications of Workmen: Workmen shall be thoroughly familiar with the type of materials being installed and the best methods for their installation.
B. Codes and Standards:
1. In addition to complying with all pertinent codes and regulations, comply with all pertinent recommendations contained in the following:
a. "Manual of Standard Practice for Detailing Reinforced Concrete Structures", ACI 315.
b. "Building Code Requirements for Reinforced Concrete", ACI 318.
c. Uniform Building Code, current edition.
d. "Placing Reinforcing Bars", Concrete Reinforcing Steel Institute.
2. Where provisions of pertinent codes and standards conflict with this Specification, the more stringent provisions shall govern.

1.03 SHOP DRAWINGS

A. Submit shop drawings for review: One set and two prints each.
1. Fully detailed shop drawings, including bending schedules and bending diagrams. Shop drawings shall show placing details and size and location of all reinforcing steel.
2. Reinforcing steel shall not be fabricated or placed before the shop drawings have received final review and returned to the Contractor. Review of shop drawings by the Architect and/or Structural Engineer will not relieve the Contractor of responsibility for errors or for failure in accuracy and complete placing of the work.
B. Mill Test Reports: Certified mill test reports (tensile and bending) for each heat or melt of steel shall be submitted to the Architect before delivery of any material to the job site.

1.04 PRODUCT HANDLING

A. Take all means necessary to protect reinforcing steel before, during, and after installation and to protect the work and materials of all other trades.

1.05 SAMPLING, TESTING, AND INSPECTION OF REINFORCING STEEL

A. Identified Reinforcing Steel: No testing of reinforcing steel will be required if reinforcing is taken from bundles identified by heat number accompanied by mill analysis and mill test reports, and is properly tagged with an identification certificate.
B. Unidentified Reinforcing Steel: The Contractor shall pay for tests to determine that the steel complies with the ASTM A615 Specifications. Tests shall be performed by a Certified Testing Laboratory acceptable to the Architect and the Owner. One tensile and one bend test shall be made for each 5 tons or fractions thereof of each size of reinforcing steel.
C. Where special inspection is required per UBC section 105, installation and placement of reinforcing steel shall be inspected by an authorized inspector prior to concrete pour.

PART 2 - PRODUCTS

2.01 REINFORCING STEEL

A. Reinforcing Bars:
1. Free from loose rust.
2. Ribbed-Steel Bars: ASTM A615, Grade 40 for #4 and #5, Grade 60 for #6 bars and larger.
3. Bars to be welded shall be welded steel ASTM A706 Grade 40 for #3 and #4, Grade 60 for #5 and larger.
B. Welded Wire Fabric: ASTM A185.
C. Welding Electrodes: as recommended by AWS D1.4-79.
D. Tie Wire: 16 gauge minimum, black and annealed.
E. Accessories: Metal or plastic system, supports, ties, etc., as required for spacing, assembling and supporting reinforcing in place.

2.02 FABRICATION

A. Comply with details on Drawings.
B. Where specific details are not shown or noted, do all detailing and fabrication in conformance with the requirements contained in the References, Codes and Standards Article.
C. Clean bars of loose rust, loose mill scale and any substance which may decrease bond. Bend bars cold and accurately to details on reviewed shop drawings. Shop fabricate all reinforcement.

2.03 OTHER MATERIALS

All other materials, not specifically described but required for a complete and proper installation of concrete reinforcement, shall be as selected by the Contractor subject to the acceptance of the Owner.

PART 3 - EXECUTION

3.01 SURFACE CONDITIONS

A. Inspection
1. Carefully inspect the installed work of all other trades prior to installing reinforcing steel and verify that all such work is complete to the point where work may commence.
2. In the event of discrepancy, immediately notify the Architect. Do not proceed with installation in areas of discrepancy until all such discrepancies have been fully resolved.
B. Clean reinforcement of loose mill scale, oil, or other coating that might destroy or reduce the bond before it is placed.

3.02 PLACING

A. General: Reinforcing steel shall be placed in accordance with the drawings and reviewed shop drawings and the applicable requirements of the References, Codes and Standards Article. Install reinforcement accurately and secure against movement, particularly under the weight of workmen and the placement of concrete.
B. Reinforcement Supports:
1. Reinforcement shall be accurately located in the forms and held in place by means of supports adequate to prevent displacement and to maintain reinforcement at proper distance from form face. Supports and their placement shall comply with CSI "Placing Reinforcing Bars". The use of wood supports and spacers inside the forms is not permitted.
2. Support reinforcement for all slabs by wiring to precast concrete blocks or chairs spaced 4' - 0" o.c. (maximum) both ways, staggered. 2" size blocks or chairs so the reinforcing is maintained at the center line of the slab.
C. Obstructions: Wherever conduits, piping, inserts, sleeves, etc., interfere with placing of reinforcing steel, obtain Architect's approval of method of procedure before any concrete is placed. Bending of bars around openings or sleeves is not permitted.
D. Tying: All reinforcing shall be rigidly and securely tied with steel tie wire at all splices and at all crossing points and intersection in the position shown. All tie wires, after cutting, shall be bent in such a manner that concrete placement will not force the wire ends to surface of concrete.

SECTION 03200 - REINFORCING STEEL (cont.)

E. Splicing: Make splices only at those locations shown on the drawings or as approved by the Structural Engineer. Stagger splices in adjacent bars wherever possible.
F. Welded Wire Fabric: Fabric shall be in long lengths as practicable and shall be wired at all laps. Edge laps shall be a minimum of 2' o-c of sleeve wires and laps shall be a minimum of 2' greater than transverse wire spacing. offset all end laps in adjacent widths. Supply all fabric in flat sheets, not rolls.
G. Dowels shall be tied securely in place before concrete is deposited. In the event there are no bars in position to which dowels may be tied, No. 3 bars (minimum) shall be added to provide proper support and anchorage. Bending of dowels after placement of concrete will not be permitted.

H. Welding: No welding or reinforcing steel or of attachments to reinforcing steel will be permitted unless the chemistry of the steel conforms to AWS D1.4-79. All electrodes shall be low hydrogen. All welding material, and wire cuttings, shall be thoroughly cleaned from forms for exposed concrete before any concrete is placed. Such welding of bars is not permitted for fabricating cages or assemblies.

PART 4 - COMPLETION

4.01 CLEAN-UP
During the progress of the work, the premises shall be kept free from debris and waste material resulting from the work of this section. Upon completion, all surplus material and debris shall be removed from the site.

SECTION 03300 - CAST IN PLACE CONCRETE

1.01 SCOPE OF WORK
Furnish all materials and labor necessary to complete cast-in-place concrete as indicated or specified herein.

1.02 STANDARDS

ACI - American Concrete Institute Sections:
ACI 301 "Specification for Structural Concrete for Buildings"
ACI 304 "Recommended Practice for Measuring, Mixing and Placing Concrete."
ACI 305 "Recommended Practice for Hot Weather Concrete."
ACI 306 "Recommended Practice for Cold Weather Concrete."
ACI 309 "Recommended Practice for Consolidation of Concrete."
ACI 310 "Building Code Requirements for Reinforced Concrete."
ASTM - American Society for Testing and Materials Section:
C-13 "Standard Specification for Concrete Aggregates."
C-19 "Standard Test Method for Compressive Strength of Cylindrical Concrete Specimens."
C-94 "Standard Specification for Ready-Mixed Concrete."
C-143 "Standard Method of Test for Slump of Portland Cement Concrete."
C-150 "Standard Specification for Portland Cement."
C-231 "Standard Test Method for Air Content of Freshly Mixed Concrete."
Comply with the Uniform Building Code, Current Edition and appropriate Sections of the UBC Standards.

1.03 SUBMITTALS

A. Quality Control
Testing laboratory as required for the tests in this section shall be approved by the Owner and shall submit the results of all tests in writing and in the required copies to the Owner. The Owner will be responsible for all testing of the mixed concrete except that the Contractor shall be responsible for all expenses incurred by the Owner for testing inspection of concrete which replaces concrete previously rejected. The Contractor shall coordinate and cooperate with the Owner in the Owner's testing and inspection program. The balance of testing as required in this Section shall be done at the Contractor's expense.
1. Mix Design: The Contractor, at his expense, shall employ the services of an independent testing laboratory to design concrete mixes for each type of concrete required. The Contractor shall submit representative samples of each type of aggregate and Portland cement to the testing laboratory for analysis and preparation of the mix design. The proportions of the materials and the water content shall be established by tests made in accordance with ASTM 211.1 for hardrock concrete and the applicable requirements of the building code. Submit test reports to the parties named above for approval from the Owner at least 7 days prior to the placing of any concrete. No concrete shall be allowed to be poured until mix designs have received final review.
2. Cement/Furnish all tests for all cement used.
3. Concrete: The Owner shall sample and test as follows:
a. Compression Tests: Make 3 standard test cylinders from each day's placing and each 100 cubic yards, or fraction thereof, of each class of concrete. Date cylinders, number and note, indicating the point from which the sample was taken. Indicate the slump test and percent air result of sample. Do not make more than 3 cylinders from any one point or batch of concrete.
b. Test Cylinders: Make test cylinders at the job, in accordance with ASTM C-31. Test cylinders ant 7 and 28 days.
c. Slump: Tests shall be in accordance with ASTM C-143.
d. Below Strength Concrete: Should the strength of the concrete, as indicated by the tests, fall below the required minimum, then additional tests on concrete, which the unsatisfactory samples represented, may be required.
4. Transit Mixed Concrete: The manufacturer of the transit mixed concrete shall deliver a certificate with each mix stating the quantity of cement, water, fine aggregate and coarse aggregate and mixers contained in the load.
5. Keep a record and make available for inspection at the site, showing the date and time of placing of concrete in each portion of the structure.

STRUCTURAL ENGINEERING

1710 ZACKER ROAD
SUITE 100
SAN JOSE
CALIFORNIA 95128

408-430-0290

MILPITAS SENIOR CENTER PHASE 2

100 North Main
Milpitas, California

Project 3360

RECORD DRAWING
4-1-93

PHASE 2	7-17-91
PHASE 2	10-22-91
ISSUE FOR BKT	12/1/91

REVISION DATE

SPECIFICATIONS

JOB# : 90-001
DRAWN : MC
DATE : 7-17-91
SCALE : NONE

S5.1

SECTION 03300 - CAST IN PLACE CONCRETE (cont.)

PART 2 - PRODUCTS

2.01 MATERIALS

- Portland Cement
ASTM C-150, Type I or II, low alkali. The brand of cement shall not be changed during the progress of the job unless approved in writing by the Structural Engineer.
- Standard Weight Aggregate
ASTM C-33 from equal parts. The maximum size used in a particular location shall be consistent with the form and location and spacing of the reinforcing steel and with the method of vibration. The coarse aggregate sized shall be such as will produce dense, uniform concrete, free of rock pockets, honeycombs or other irregularities.
- Water
Clean and free of deleterious amounts of acid, alkalis, salt, oils or organic substances.
- Admixtures
Except as otherwise specified, admixtures, if used, shall be supplied by one manufacturer and batched in strict accordance with manufacturer's recommendations throughout project. Admixture brands are subject to prior written acceptance of the Structural Engineer. All concrete shall contain an air entraining admixture conforming to ASTM C-260.

2.02 CONCRETE

- All concrete shall be regular weight concrete weighing approximately 150 pounds per cubic foot. Contractor shall be solely responsible for the design of concrete mixes to meet all the requirements of the specifications.
- All concrete shall contain 1" maximum aggregate and shall attain a 28 day compressive strength of 3000 PSI except exterior site concrete which shall attain a 28 day compressive strength of 2000 PSI.
- Slump limits: minimum 2", maximum 4" as per ASTM C-143.
- Air entrainment limits: minimum 3.5% maximum 4.5%.
- Admixtures
Admixtures shall be of the strength recommended by the manufacturer, but shall not cause retardation greater than 90 minutes.
- Non-shrink Grout
Approved packaged product, such as: (1) 241 57-100 or equal compound by USA Corp., Specification CSD-C 621, 6000 psi.
- Cement Grout

2.03 MISCELLANEOUS

- Expansion Joint Fillers: ASTM D1751, asphaltic compound strips, 1/4" thick unless otherwise noted, pre-cut to proper size.
- Curing Materials: ASTM C-171 Moisture Retaining Cover; ASTM C-309 Liquid Membrane. Material shall not contain hydrocarbon substances.
- Vapor Barriers
Vapor barrier below concrete shall be 6 mil. minimum, polyethylene sheeting, in sheets as wide as possible to minimize joints or glue joints per the manufacturer's recommendations.
- Sand for Cushion
Clean and free of organic matter or deleterious material.
- Joint Sealant
"Epoxyastic Sealant Two-Part" as manufactured by Soudabond Concrete, Building Products Division, Contech, Inc., 330 Bruce Street, Oakland, CA 94607, (415) 835-1718, or approved equal. Bond breaker tape to be as recommended by sealant manufacturer.
- Backer Rod
"Soudabond Backer-Rod" as manufactured by Soudabond-Contech, Building Products Division, Contech, Inc., or approved equal.

2.04 OTHER MATERIALS

- All other materials, not specifically described but required for a complete and proper installation of the cast-in-place concrete shall be as selected by the Contractor subject to the acceptance of the Architect.

PART 3 - EXECUTION

3.01 GENERAL

- Preparatory Provisions
Prior to placement of concrete this Contractor shall be responsible for the examination and acceptance of all conditions affecting the proper installation of his work and shall not proceed until all unsatisfactory conditions have been corrected.
- Notify the Architect at least 48 hours before placing concrete.

3.02 SURFACE CONDITIONS

- Inspection
Prior to all work of this Section, carefully inspect the installed work of all other trades and verify that all such work is complete to the point where this installation may properly commence.
- Discrepancies
In the event of discrepancy, immediately notify the Architect. Do not proceed with installation in areas of discrepancy until all such discrepancies have been fully resolved.

3.03 PREPARATION

- General
Thoroughly clean the areas to ensure proper placement and bonding of concrete.

3.04 MIXING

- Concrete shall be ready mixed as per ASTM C-94. No water shall be added to the mix after the initial introduction of mixing water for the batch except when, on arrival at the job site, the slump of the concrete is less than that specified.

3.05 TRANSIT-MIX DELIVERY SLIPS

- Keep a record at the job site showing time and place of each pour of concrete, together with transit-mix delivery slip certifying contents of the pour. Delivery tickets shall show departure time from plants. Records shall be made available to the Architect.

3.06 PLACING

- All absorbent forms shall be thoroughly wetted down before concrete is placed. Subgrade for slabs on grade shall be moist but not saturated when concrete is placed.
- Placing of concrete shall be done immediately after mixing. No concrete shall be placed or used after it has begun to set and no re-tempering will be allowed. The method used in placing shall be such that concrete is conveyed to place and deposited without separation of the ingredients. No concrete shall be placed with a free unfaced fall in excess of five (5) feet nor shall it be as to create segregation. Do not support runways on reinforcing steel.
- Splash or accumulations of hardened or partially hardened concrete shall be removed as directed.
- Deposit concrete in approximate horizontal layers not exceeding 18" thickness, unless otherwise authorized. Placing of concrete shall be carried on in a continuous operation without interruption until placing, of course, section, panel or monolith is completed.
- Distribution of concrete shall be even and continuous and no pour joints shall show.
- No concrete shall be placed for any element until all reinforcing for same is fastened in place nor until forms are complete. No concrete shall be placed before all work that is to be embedded has been set. Reinforcing or other materials that have been set shall not be disturbed.
- No pipes or conduits shall be embedded in structural concrete unless specifically approved by the Structural Engineer prior to embedment. Before placing concrete all pipes and conduits that pass thru a wall or slab shall be sleeved providing 1/4" clearance (minimum) all around. Sleeves shall be positioned so as not to impair strength of surrounding elements. Sleeves and inserts will be provided and set under other sections of the work.

SECTION 03300 - CAST IN PLACE CONCRETE (cont.)

- Verify depths of depressed slab conditions for suitability with type and method of surfacing to be applied over concrete.
- Install various inserts, anchorages, etc., required by public and private utility companies to accommodate miscellaneous metal items and equipment furnished by them.
- Concrete and/or grout shall be removed from all surfaces that will receive painter's finish.
- Place no concrete in water unless written permission has been obtained from the Structural Engineer.

- VIBRATION AND COMPACTION
A. All concrete over 6 inches in depth shall be thoroughly compacted by means of internal mechanical vibrators. Under no condition shall vibrator be placed against reinforcing steel or attached to forms. Use no vibrators to transport materials.

- CONSTRUCTION JOINTS
A. Placement of construction joints and the manner in which they are provided for shall be only as approved by the Structural Engineer or as shown on the drawings. Construction joints shall be as few as possible and will not be permitted simply to save forms.
- All construction joints including keys shall be cleaned and roughened by removing entire surface and exposing clean aggregate solidly embedded by means of sandblasting or other approved methods.

- CURING FORMED CONCRETE
Keep all formed concrete surfaces continuously wet both in form and after removal of forms for at least seven (7) days after placing. If forms are permitted to be removed prior to expiration of curing period, exposed concrete surfaces shall be kept continuously wet by means of fog sprays or non-staining cotton or burlap mats kept moist. Plastic sheeting is not permitted. Alternatively, if chemical curing compound is to be used, the curing compound must meet the moisture retention requirements of ASTM C 309 at the coverage used on the job. Compound Complies by Master Builders or Sikagard by Sika or approved equal.

- EXPANSION
A. Expansion Joints and Edging shall be provided at all locations where concrete paving abuts buildings, curbs, or other structures.

- GROUTING OF STEEL BASE PLATES
A. All grout used for the grouting of base plates shall be non-shrink, non-shrink grout compound applied in strict accordance with manufacturer's directions.
- All grouting of bases shall be carefully done so as not to leave any voids between the base plates and the concrete.

- MEMBRANE AND SAND CUSHION
A. Membrane: Place completely over capillary break material subgrade. Lap joints 6 inches, minimum and continuously tape or glue per manufacturer's recommendations.
- Sand Cushion: Place a sand cushion on top of membrane immediately after placing membrane.

- HOT AND COLD WEATHER REQUIREMENTS
A. Cold Weather Placing: Mix and place concrete per ACI 604 "Recommended Practice for Winter Concrete Methods", except use of calcium chloride not permitted.
- Hot Weather Placing: Place concrete at lowest practicable temperature. When hot weather conditions would seriously impair quality and strength of concrete, place concrete per ACI 605 "Recommended Practice for Hot Weather Concrete", except as otherwise indicated.

- QUALITY CONTROL
A. Testing and inspection services shall be retained by the Owner at his expense except that when excessive inspection and testing costs result from the Contractor's scheduling of work or his construction operations or when tests or inspections reveal failures of materials to meet contract requirements, all such excessive costs and all costs for subsequent tests and inspections will be deducted from the Contract price.

3.15 LEVELING AND FINISHING

- General
Temp slabs with a jacking to depress the rock, and then pushfloat with a bullfloat as necessary.
- Finishes: All floor slabs shall have a monolithic finish. Screed concrete to accurate level grades and tamp with approved metal grid tamps to bring fines to top. Delay troweling until water sheen has disappeared. No dusting will be permitted. Finished floors shall contact a 10' straight edge between changes in slope with a plus or minus tolerance of not to exceed 1/8". Cement floors shall be sloped to floor drains as indicated. Finished surfaces shall be as follows:
a. Exposed concrete floors, concrete floors to receive resilient flooring and carpet and concrete stair landings shall be screeded to an even, level finish. Surfaces shall be free from depressions, trowel marks, scale and foreign deposits.
- Formed Surfaces: Patch holes and defects and rub down fine using wood blocks. Otherwise, surfaces shall be left with the texture imparted by the forms.

3.16 CONCRETE SURFACE REPAIRS

- Patching Defective Interior concrete or Concrete Surfaces: Repair and patch defective areas with cement mortar immediately after removal of forms. Cut out honeycomb, rock pockets, voids over 0.6 cm (1/4") in any dimension, down to solid concrete, but, in no case to a depth of less than 2.5 cm (1"). Make edges of cuts perpendicular to the concrete surface. Before placing the cement mortar, thoroughly clean, dampen with water, and brushcoat the area to be patched with neat cement grout. Repair exposed-to-view formed concrete surfaces that contain defects that adversely affect the appearance of the finish. Remove and replace the concrete having defective surfaces if the defects cannot be repaired to the satisfaction of the Architect. Correct high areas in concrete by grinding after the concrete has cured sufficiently so that repairs can be made without damage to adjacent areas. Correct low areas in surface by leveling or immediately after the completion of surface finishing operations by cutting out the low area and replacing with fresh concrete.

SECTION 05210 - STEEL OPEN WEB JOISTS & GIRDERS

PART 1 - GENERAL

1.01 SCOPE OF WORK

- Furnish all labor, materials and equipment and services necessary to provide all steel open web joists and open web girders, complete in place as shown on the drawings or specified herein.
- Work Specified in this Section
1. Steel open web joists, steel open web girders, bridging and accessories in connection with steel joist and girder and their erection.
2. Welding, bolting and furnishing anchors, clips, hanger rods, clevises, turnbuckles and other required accessories for installing the work of this Section.
3. Shop painting.
4. Field painting.
5. Shop drawings and design submittals.
- Related Work Specified in other Sections
1. Structural Steel - Section 05100
2. Metal Decking - Section 05300
3. Metal Fabrications - Section 05500

1.02 STANDARDS

- American Welding Society (AWS) Publications:
Structural Welding Code, Steel, D1.1-80.
- American Institute of Steel Construction (AISC) Manual, 8th Edition: and Steel Joist Institute Specifications.
- Standard Specifications for Open Web Steel Joists, a Open Web Girders.
- Steel Structures Painting Council (SSPC) Specification: SS 14.01.
- Steel Joist Shop Paint System

1.03 SUBMITTALS

- Manufacturer's Data
1. Producer's or manufacturer's specifications and installation instructions for the following products: Include laboratory test reports and other data as required to show compliance with specified requirements:
a. Structural steel (each type), including certified copies of all reports covering chemical and physical properties.
b. Bolts (each type) including nuts and washers.
c. Structural steel primer paint.
- Certificates of conformance or compliance for joists and accessories.
- Shop Drawing & Design Calculations
Submit copies of design calculations, shop details, and erection details signed by a State of California registered Civil or Structural Engineer retained by the Contractor to the Architect. Fabrication shall not be started until review is completed and shop drawings have been returned to the Contractor.
- Shop drawings including complete details and schedules for fabrication and shop assembly of members include details of cuts, connections, camber, holes, and other pertinent data. Indicate welds by AWS symbols, and show size, length, and type of weld. Provide erection drawings. Identify details by reference to sheet and detail number on drawings. Shop drawings shall show joist type and size, layout in plan, method of bracing, framing at openings, spacing of bridging, and requirements for field welding.
- Design calculations shall include complete analysis and design of joists and girders being supplied including, but not limited to design criteria used, design assumptions, member stresses and deflections, camber and connection design. Design shall be in conformance with criteria as put forth on the drawings and the applicable codes and standards.

1.04 PRODUCT HANDLING

- Delivery and Storage
Deliver all materials to the job site properly marked to identify the structure for which it is intended, marking shall correspond to that indicated on the shop drawings. Store in a manner in maintains identification and to prevent damage.
- Replacements
In the event of damage, immediately make all repairs and replacements necessary to the approval of the Architect at no additional cost to the Owner.

1.05 QUALITY ASSURANCE

- Shop Welding
AWS D1.1 Perform welding with qualified welders. The qualification of welders and the duration of qualification period shall be in accordance with the requirements of AWS D1.1. Welders who have not performed welding for the period of three or more months shall be requalified.
- Mill reports as specified in Section 1.03.

PART 2 - PRODUCTS

2.01 MATERIAL

- Steel
The steel used in the manufacture of chord and web section shall conform to one of the following ASTM Specifications of latest edition:
1. Structural Steel, ASTM A36.
2. High-Strength Low-Alloy Structural Steel, ASTM A572.
3. High-Strength Low-Alloy Structural Manganese Vanadium Steel, ASTM A441.
4. Hot Rolled Carbon Steel Sheets and Strip, Structural Quality ASTM A570.
5. High-Strength Low-Alloy Columbium-Vanadium Steel of Structural Quality, ASTM A572 Grades 42, 45, and 50.
6. High-Strength Low Alloy Structural Steel with 50,000 psi Minimum Yield Point to four inches thick, ASTM A588.
7. Steel Sheet and Strip, Hot-Rolled and Cold-Rolled, High-Strength, Low-Alloy, with Improved Corrosion Resistance, ASTM A572 Grades 42, 45, and 50.
8. Steel Sheet and Strip, Hot-Rolled and Cold-Rolled, High-Strength, Low-Alloy, Columbium-Vanadium, ASTM A572 Grades 42, 45, and 50.
9. Steel, Cold-Rolled Sheet, Carbon Structural, ASTM A511 Grade D.
- Joists and Accessories
Except as otherwise specified herein, joists and accessories shall be in accordance with the applicable AISC and AISC Standard Specifications.
- Welding Electrodes
The following electrodes shall be used for arc welding:
For connected members both having a specified minimum yield strength greater than 35,000 psi:
AWS E5.1 or E5.5, E70XX
AWS E5.17, E7T, E8XX flux electrode combination
AWS E5.18, E70S-X or E70U-1
AWS E5.28, E70T-X
D. Shop Painting
Clean and prime joists in accordance with SSPC 14.01, Steel Joist Shop Paint System, except that paint shall conform to R7 Specifications and shall be suitable for top coating.
- Paint
Paints used for touchup and shop painting may contain toxic lead or zinc compounds. Appropriate measures shall be taken by the Contractor to control worker exposure to toxic substances during their use.
- Machine bolts: ASTM A307

SECTION 05210 - STEEL OPEN WEB JOISTS & GIRDERS (cont.)

PART 3 - EXECUTION

- Installation
Each joist shall be adequately braced laterally before the next joist is erected and before any loads are applied. If lateral support is provided by bridging, the bridging lines as defined below must be anchored to prevent lateral movement. Bridging cables shall not be released until one line of braced bridging nearest the third points of the span for spans up to 100 feet and all bridging lines for spans over 100 feet are installed. During the construction period, the Contractor shall provide means for the adequate distribution of concentrated loads so that the carrying of any joist is not exceeded.
- Handling
Except as otherwise specified herein, handling and erection shall be in accordance with the applicable R7 Standard Specification for the joist series indicated. Provide sufficient bracing, shoring, and guying to effect safe and satisfactory erection. Provide bracing and shoring capable of holding steel work plumb and properly aligned while field connections are being made. It shall be the Contractor's full responsibility to provide the necessary complete temporary bracing for safe erection of structure.
- Field Welding of Steel Joists:
AWS D1.1 Perform welding with qualified welders. The qualification of welders and the duration of qualification period shall be in accordance with the requirements of AWS D1.1. Welders who have not performed welding for a period of 3 or months shall be requalified. Welders whose work falls to pass inspection shall be requalified before performing further welding. Contractor shall pay costs of certifying qualifications.
- Touch up Painting
After erection of joists, connections and areas of abraded shop coat shall receive touch up paint of the same type used on shop coat.
- Assembly work where indicated with ASTM A307 bolts, ASTM A325 bolts, or field welding as specified. Provide for erection bolting of all open web joists and girders.

SECTION 05500 - STRUCTURAL STEEL

PART 1 - GENERAL

1.01 GENERAL

- Furnish all labor, materials, equipment and services necessary to provide all structural steel complete in place, as shown on the drawings or specified herein.

1.02 DESCRIPTION

- Work Included:
Structural steel required for this Work is indicated on the drawings.

1.03 QUALITY ASSURANCE

- Qualifications of Suppliers and Personnel:
1. The steel fabricator shall have not less than five years continuous experience in the fabrication of structural steel.
- The steel erector shall have not less than five years continuous experience in the erection of structural steel.
- Welding shall be performed by welders and operators who have been recently qualified as prescribed in "Qualification Procedure" of American Welding Society.
- Tests and Testing
1. Steel shall be tested, if required, in tension in accordance with ASTM A370.
2. Submit mill analysis and test reports for acceptance. Where samples are taken from steel as delivered from the mill, analysis and test reports accompanying the submittal, then no tests will be required.
- Where positive identification of heat number cannot be made, then one series of tests shall be made for each five tons or fractional part thereof of each size of member used, in which case costs of tests shall be borne by the Contractor.
- Steel that is delivered to the job without being accepted before shipment will be rejected and must immediately be removed from the premises.
- Codes and Standards
In addition to complying with all pertinent codes and regulations, comply with:
1. Specification for the design, fabrication, and erection of Structural Steel for Buildings: of the American Institute of Steel Construction (A.I.S.C.).
2. Structural Welding Code: Steel AWS D1.1-82.
3. Applicable ASTM specifications for steel items specified.
- Specifications for Structural Joints using ASTM A325-B7 and A490-B7 Bolts, by the Research Council of Riveted and Bolted Structural Joints of the Engineering Foundation.
- Federal specifications for red lead and zinc chromate paint.
- Current Uniform Building Code.
- Conflicting Regulations
In the event of conflict between pertinent codes and regulations and the requirements of the referenced Standards or these Specifications, the provisions of the more stringent shall govern.

1.04 SUBMITTALS

- Shop Drawings and erection details including cuts, copes, connections, holes, threaded fasteners and welds. Show all locations, markings, quantities, materials, sizes and shapes.
- Reports for information and records:
1. Proof of qualifications for welders.
2. All certificates, tests and inspections - whether shop or field required.

1.05 PRODUCT HANDLING

- In the event of damage, immediately make all repairs and replacements necessary to the acceptance of the Architect at no additional cost to the Owner.

PART 2 - PRODUCTS

2.01 STRUCTURAL STEEL

- All steel shapes, bars and plates: ASTM A36.
- Structural tubing: ASTM A500, Grade B.
- Welded Studs: Welded Studs type E3C E34 as approved for the required concrete strength.
- Non-shrink Grout: Soudabond or an approved equal.

2.02 BOLTS AND NUTS AND WASHERS

- Machine Bolts - ASTM A307 (shall have threads excluded from the shear plane).
- Anchor Bolts: ASTM A307.
- Nuts: ASTM A563.
- Washers: ASTM A436.

2.03 PRIMER PAINT

- Conform with Federal Specification TT-P-445A



STRUCTURAL ENGINEERING

1719 ZACKER ROAD
SUITE 103
SAN JOSE
CALIFORNIA 95128

408-430-6260

MILPITAS SENIOR CENTER PHASE 2
160 North Main
Milpitas, California
Project 3360

RECORD DRAWING 4-1-83

PHASE 2	7-17-91
PHASE 2	10-22-91
ISSUED FOR BID	12/11/91

REVISION DATE

SPECIFICATIONS

JOB# : 90-001
DRAWN : MC
DATE : 7-17-91
SCALE : NONE

S5.2

SECTION 05500 - STRUCTURAL STEEL (cont.)

- 2.04 FABRICATION**
- A. General: Fabricate all structural steel in strict accordance with the final Shop Drawings and the referenced Standards.
- B. Fabricate and preassemble work in shop to greatest extent possible.
- C. Where connection is not shown, design in accordance with standard practices in a manner similar to like connections shown, unless otherwise directed by the Architect.
- D. Shop cleaning and priming:
- Thoroughly clean all structural steel and assemblies, removing rust as scale, and shop prime with one coat of primer paint, except:
 - Surfaces to be encased in concrete.
 - Surfaces to be field welded.
- E. Thoroughly clean all steel to be encased in concrete or fireproofed.
- F. Holes for bolted connections shall be drilled or punched 1/16" larger than bolt diameter. Holes in base plates for anchor bolts may be 5/16" oversize.
- 2.05 WELDING**
- A. General:
- For details of joints, comply with requirements for AISC welded joints.
 - Electrodes for shielded metal arc welding: AWS A5.1 E70XX. Electrodes for submerged arc welding: AWS A5.17 E7XX-EXXX.
 - Follow applicable sections of AWS specifications D1.1.
- B. Types of Welds: Unless otherwise noted:
- Make all fillet welds 3/16" minimum.
 - Make all butt welds complete penetration welds, using back-up or chip and back weld.
 - Welds not required to be complete penetration welds are specifically noted on the Drawings.
- 2.06 OTHER MATERIALS**
- All other materials not specifically described but required for a complete and proper installation shall be new, free from rust, first quality of their respective kinds, and subject to the acceptance of the Owner.
- PART 3 - EXECUTION**
- 3.01 SURFACE CONDITIONS**
- A. Inspection:
- Prior to installation of the work of this Section, carefully inspect the installed work of all other trades and verify that all such work is complete to the point where this installation may properly commence.
 - Discrepancies: In the event of discrepancy, immediately notify the Architect. Do not proceed with fabrication of installation in areas of discrepancy until all such discrepancies have been fully resolved.
- 3.02 ERECTION**
- A. General:
- Erect all steel in strict accordance with the Drawings, the Shop Drawings bearing the Reviewer's Final Stamp, and all pertinent Regulations and Standards. Particular attention shall be given during fabrication and erection to maintain true lines and plumb members with tolerance conforming to Section 1.7.3.8 of the AISC Specifications and Section 7 of the AISC Code of Standard Practice for Steel Buildings and Bridges.
- B. Bolting: Comply with AISC requirements.
- C. Field Welding: Comply with requirements given for welding under Part 1 and Part 2 above.
- D. Tolerances: Set all steel members in true alignment within a tolerance of one in 300.
- E. Touch-Up: After erection is complete, touch-up shop prime coats damaged during transportation and erection, and prime exposed field welds and field bolts, using prime paint specified for shop priming.
- F. Cleaning Up: After erection is complete, touch-up shop prime coats damaged during transportation and erection, and prime exposed field welds and field bolts, using prime paint specified for shop priming.
- G. Welded shear studs: Shall be shop fillet and plug welded or automatically welded accordance with the manufacturer's recommendation as indicated on the drawings.
- 3.03 INSPECTION**
- A. Material and workmanship at all times shall be subject to the inspection of the Owner, Architect, Engineer and/or the Testing Laboratory.
- B. Material or workmanship not conforming to provisions of this specification shall be rejected at any time defects are found during the progress of the work.
- C. Shop and Field Welding: Continuous inspection of welding in the field shall be required during the time of welding. In addition, all complete penetration welds shall be ultrasonically tested by the Laboratory, unless some other means of proving the compliance of the welds is designated by the Structural Engineer. Procedures and criteria for acceptance of welds shall be per AWS D1.1.
- D. Welding Inspector: Inspection of all shop and field welding operations shall be made by a qualified welding inspector selected by the Owner.
- 3.04 TESTS**
- A. All tests shall be made by a Testing Laboratory selected and provided by the Owner.
- B. Identified Material: If steel can be identified by heat or melt number and is accompanied by mill analysis and test reports, commercial stock may be used. The Contractor shall furnish the certified mill test reports.
- C. Unidentified Material: When material cannot be identified or its source is questionable, one set of physical tests shall be made for each five tons or fractional part thereof of each size, at the Contractor's expense.

SECTION 06100 - ROUGH CARPENTRY

PART 1 - GENERAL

- Furnish all labor, materials, equipment and services necessary to provide all concrete reinforcing steel, complete in place, as shown on the drawings or specified herein.
- 1.01 QUALITY ASSURANCE**
- A. Governing Specifications: Materials and installation of Rough Carpentry shall comply with pertinent provisions of the following:
- Douglas Fir, Hemlock and Cedar: Number 16, January 1978
 - Standard Grading and Dressing Rules for West Coast Lumber: Number 16, January 1978
 - Standard Specifications for Grade of California Redwood Lumber: 1975, published by Redwood Inspection Service.
 - Product Standard PS-109 of the U.S. Department of Commerce, Bureau of Standards.
- B. Redwood: "Standard Specifications for Grade of California Redwood Lumber", 1975, published by Redwood Inspection Service.
- C. Plywood: Product Standard PS-109 of the U.S. Department of Commerce, Bureau of Standards.

SECTION 06100 - ROUGH CARPENTRY (cont.)

- 4. Pressure Treatment:** Standards C1 and C2 of the American Wood Preservers Association (AWPA) latest edition.
- 5. Rough Hardware:** "Specification for the Design, Fabrication and Erection of Structural Steel for Buildings", of the American Institute of Steel Construction latest edition.
- 6. Building Paper:** Federal Specification UU-3-790a, dated February 5, 1978.
- 7. Wood:** Standard P-5 of the American Wood Preservers Institute, latest edition.
- B. Standards:** All work shall conform to the Current Uniform Building Code and the American Institute of Timber Construction requirements.
- C. Conflicting Requirements:** In the event of conflict between pertinent codes and regulations and the requirements of the referenced standards or these Specifications, the provisions of the more stringent shall govern.
- 1.02 PRODUCT HANDLING**
- Protection: Use all means necessary to protect lumber materials before, during and after delivery to the job site, and to protect the installed work and materials of other trades.
- PART 2 - PRODUCTS**
- 2.01 IDENTIFICATION**
- A. Framing Lumber: Identify each piece with the grade stamp of the West Coast Lumber Inspection Bureau.
- B. Plywood: Identify each sheet with the grade stamp of the American Plywood Association.
- C. Redwood: Identify each piece with the grade stamp of the Redwood Inspection Service.
- D. Other: Identify all other materials of this section by the appropriate stamp of the Agency listed in the referenced standards, or by each other means as are acceptable in the advance by the Project Inspector.
- 2.02 LUMBER**
- A. General:
- Framing lumber 5" and larger in the least dimension shall not contain bored heart.
 - Beams shall not have splits or checks longer than the wide face dimension.
 - Moisture content shall be 19% maximum.
 - Finish shall be #1S, except that lumber may be #2S at unexposed framing.
 - Redwood shall be all heart wood.
- B. Schedule:
- Sills on Concrete: Foundation Grade Redwood, Grade marked at the mill. Paragraph 319 or No. 1 Grade Pressure Treated Douglas Fir.
 - Studs: 2X4 and 2X6: Douglas Fir, No. 2, 1200f.
 - Structural Light Framing: 2" to 4" thick, 2" to 4" wide: Douglas Fir, No. 2, 1450f.
 - Structural Joists: 2" to 12" thick, 5" and wider: Douglas Fir, No. 2, 1250f.
 - Structural Partials: 4" thick, 5" and wider: Douglas Fir, No. 2, 1250f.
 - Beams & Stringers: 5" and thicker: Douglas Fir, No. 1, 1200f.
 - Posts: Douglas Fir, No. 1; 1200f, 1150c.
- 2.03 PLYWOOD**
- A. Plywood Roof Sheathing: 5 ply, STRUG, I DOUGLAS FIR plywood, 5/8" thick unless otherwise noted on the drawings.
- 2.04 PRESSURE TREATMENT**
- A. Ammoniacal copper arsenite, conforming to AWPA Standard P-5 (Water-Borne Preservative), Chromonite, J.B. Baxter, or equal by McCormic & Baxter. Retention shall be 0.23 lb. per cu. ft. in accordance with AWPA Standards C1 and C2.
- 2.05 FASTENERS**
- A. Nails: Domestic Common (unless otherwise noted) otherwise on Drawings; Federal Specification FF-A-121. Hot-dipped galvanized at ext. locations.
- B. Machine Bolts: ASTM A-307
- C. Lag Bolts: Federal Specification FF-B-561.
- D. Plain Washers: Round, carbon steel, Federal Specification FF-N-92.
- 2.06 METAL FRAMING DEVICES**
- A. Steel Hardware: ASTM A-36. Hot-dipped galvanized at exterior locations. Welds per A.W.S. requirements.
- B. Framing hangers, Straps and Other Connectors: Simpson or E. Metals. Hot-dipped galvanized at exterior locations. Welds per A.W.S. requirements.
- 2.07 OTHER MATERIALS**
- A. All other materials, not specifically described but required for a complete and proper installation as shown on Drawings, shall be new, suitable for the intended use and subject to the acceptance by the Architect.

PART 3 - EXECUTION

3.01 WORKMANSHIP

- A. General:
- All rough carpentry shall produce joints true, tight and well nailed with all members assembled in accordance with the Drawings and with all pertinent codes and regulations. Framing shall be straight, true and plumb.
- B. Selection of Lumber Pieces:
- Carefully select all members; select individual pieces so that knots and obvious defects will not interfere with placing knots for proper nailing or making proper connections.
 - Cut out and discard all defects which will render a piece unable to serve its intended function; lumber may be rejected by the Project Inspector whether or not it has been installed, for excessive warp, twist, bow, crook, mildew, fungus or mold, as well as for improper cutting and fitting.
- C. Shimming: Do not shim sills, joists, short studs, trimmers, headers, lintels or other framing components.

SECTION 06100 - ROUGH CARPENTRY (cont.)

- 3.02 LUMBER TREATED WITH WOOD PRESERVATIVE**
- A. General: Wood preservative, non-pressure, shall be applied as follows to all lumber other than Foundation Grade Redwood:
- All wood embedded in or placed against concrete.
 - Perform all treatment in strict accordance with the published recommendations of the manufacturer of the treatment preservative, and a minimum of two hours before installation but after all cutting is completed on the members.
- 3.03 PRESSURE TREATED LUMBER**
- A. General: Provide pressure treatment for all lumber other than Foundation Grade Redwood located within 1-1/2" of concrete.
- B. Treatment: Perform all pressure treatment in strict accordance with the published recommendations of the manufacturer of the treatment preservative. Kill dry to 19% maximum moisture content after treatment. Handle treated lumber and penetration damage in accordance with AWPA M-4.
- 3.04 GENERAL FRAMING**
- A. General:
- In addition to all framing operations normal to the fabrication and erection shown on the Drawings, install all backing required for the work of other trades. Install blocking, striping, grounds, curbs, cants, etc. indicated specified or required.
 - Set all horizontal or sloped members with crown up.
 - Do not notch, bore or cut members for pipes, ducts, conduits or other reasons except as shown on the Drawings or as specifically approved in advance by the Structural Engineer.
 - Joists and beams at same level shall be connected with metal framing devices, "U" type, unless noted otherwise.
- B. Bearings:
- Make all bearings full unless otherwise indicated on the Drawings. Set headers on edge, supported on each end by cripples.
 - Finish all bearing surfaces on which structural members are to rest so as to give sure and even support; where framing members slope, cut or notch the ends as required to give uniform bearing surface.
- 3.05 BLOCKING AND BRIDGING**
- A. Blocking:
- Install all blocking as required by governing codes and as required to support all items of finish and to cut off all concealed draft openings, both vertical and horizontal, between ceiling and floor areas.
 - Install 2 X blocking at all intersections and edges of finished surfaces for bearing, and at all points where required to support fixtures, cabinets, hardware and equipment of any other trade. Blocking to receive fixtures shall be secured to framing with steel clips.
 - Install 2 X blocking between studs at 2'-0" centers vertically to provide nailing for all vertically applied board on board exterior siding or interior paneling.
 - Frame-block in the following specific locations:
 - In all stud walls at ceiling and floor levels.
 - In all stud walls, including stairs and furrow spaces, so that the maximum dimension of each concealed space is not more than eight feet.
 - All other locations where openings could afford passage for rodents or flames.
- B. Bridging:
- Install wood solid blocking between joists where the span exceeds eight feet.
 - The distance between a line of bridging and a bearing shall not exceed six feet.
 - Bridging may be omitted for roof and ceiling joists eight inches (nominal) in depth where the omission is permitted by code, except where otherwise indicated on the Drawings.
 - Install solid blocking between joists at all points of support and wherever sheathing or flooring is discontinued.
 - Blocking may be omitted where joists rest on ribbons and are nailed to studs, and where joists are supported on metal hangers which are capable of providing lateral support.
- 3.06 STUD WALLS AND PARTITIONS**
- A. Studs: Make all studs single length, unspliced, and platform or balloon framed as shown on the drawings.
- B. Corners and Intersections: Unless noted otherwise on the Drawings, frame all corners and intersections with three or more studs and all required bearing for wall finish.
- 3.07 ALIGNMENT**
- A. On all framing members to receive a finished wall or ceiling, align the finish substructure to vary not more than 1/8" from the plane of surfaces of adjacent framing and furring members.
- 3.08 INSTALLATION OF PLYWOOD SHEATHING**
- A. Placement:
- Place all plywood with face grain perpendicular to supports and continuously over at least two supports, except where otherwise noted on the Drawings (see panelized roof systems).
 - Center joints accurately over supports; unless noted otherwise on the Drawings, stagger the end joints of plywood panels to achieve a minimum of continuity of joints.
 - Set all panel edges to framing members or blocking at least 1-1/2" thick. Space nails at panel edges as indicated on the Drawings or if not shown, in accordance with U.B.C. requirements. Place nails not less than 3/8" from panel edges and driven solidly into the support.
- B. Protection of Plywood: Protect all plywood from moisture by use of all required waterproof coverings until the plywood has in turn been covered with the next succeeding component or finish.
- 3.09 FASTENING**
- A. Nailing:
- Use only domestic common wire nails or spikes of the dimensions shown on the Nailing Schedule, except where noted otherwise on the Drawings.
 - All nailing to conform to minimum requirements shown on the Drawings.
 - For conditions not covered on the Drawings, provide penetration into the piece receiving the point of nail or spike provided, however, 16d nails may be used to connect two pieces of two inch (nominal) thickness.
 - In diaphragms, the minimum penetration shall be 1-1/2" for 8d nails and 1-3/8" for 16d nails.
 - Do all nailing without splitting wood, preboring as required; replace all split members.
- B. Bolting:
- Drill holes 1/16" larger in diameter than the bolts being used; drill straight and true from one side only.
 - Bolt threads must not bear on wood; use washers under head and nut where both bear on wood; use washers under all nuts.
- C. Lag Screws:
- Anchorage embedded in place lagged to shall not be less than 8.6 lag screw length nor less than eight times lag screw diameter.
 - Prebore holes for lag screws same diameter as root of thread; enlarge holes to shank diameter for

SECTION 06100 - ROUGH CARPENTRY (cont.)

- length of shank.
- J. Screw, do not drive, all lag screws.
- D. Washers:
- Holes or bolts in shear shall have a net area of not less in thickness than 1/10 the length of the washer's longest side, or of malleable iron having a thickness of not less than 1/2 the bolt or screw diameter. Use malleable iron washers in all exposed locations.
 - Washers shall have a bearing surface for the nut or head which is not less than equal in diameter to the long diameter of the nut or head.
- E. Anchor Bolts:
- Anchor bolts on concrete with 5/8" diameter x 12" anchor bolts x 48" o.c. maximum spacing, minimum 2 each piece and one within 9" of each end, unless noted otherwise on the Drawings.
 - Provide one anchor 9" of each side of holes of notches 1-1/8" or larger.
- 3.10 SEALING**
- A. Seal ends of beams 3" or thicker with two coats of sealer.
- B. Seal ends of plywood that will be exposed to weather with three coats of sealer.
- 3.12 CLEANING UP**
- A. General: Keep the premises in a neat, safe and orderly condition at all times during the execution of this portion of the work, free from accumulation of sawdust, cut-ends and debris.
- B. Sweeping:
- At the end of each working day, or more often if necessary, thoroughly sweep all surfaces where debris from this portion of the work has settled.
 - Remove the refuse to the area of the job site set aside for its storage.

SECTION 06100 - GLOUED LAMINATED MEMBERS

PART 1 - GENERAL

- 1.01 WORK INCLUDED**
- Furnish all labor, materials, equipment and services necessary to provide all concrete reinforcing steel, complete in place, as shown on the drawings or specified herein.
- 1.02 QUALITY ASSURANCE**
- A. Manufacturer/Current Licensee of American Institute of Timber Construction (AITC).
- B. Codes and Standards:
- Standard Specifications for the Design and Fabrication of Structural Glued Laminated Lumber, published by West Coast Lumbermen's Association.
 - Inspection Manual (AITC 100), published by the AITC.
 - Uniform Building Code, current edition.
 - Timber Construction Standards, published by the AITC.
 - West Coast Lumber Inspection Bureau Standard Grading and Dressing Rules (No. 16).
- 1.04 SUBMITTALS**
- A. For Review: Shop Drawings for each piece to be erected. Show dimensions, adhesive types, grades, combination symbols, erection details, etc.
- B. For Information and Record: AITC Certificate of Conformance, indicating size, species, finish and glue for each member. Each certificate shall have a statement signed by the inspector that the finished members comply with the requirements of the Contract Documents.
- 1.05 PRODUCT HANDLING**
- A. Protection: Protect glued laminated members before, during, and after installation and protect the installed work and materials of all other trades.
- B. Replacements: In the event of damage, immediately make all repairs and replacements necessary to the approval of the Architect and at no additional cost to the Owner.
- PART 2 - PRODUCTS**
- 2.01 IDENTIFICATION**
- Each member shall inconspicuously bear the quality mark of the AITC for the grade specified.
- 2.02 GLOUED LAMINATED BEAMS**
- A. Species: Douglas Fir, Coast Region, Combination 24f, Table 1, graded in accordance with West Coast Lumber Bureau (WCLB) "Standard Grading and Dressing Rules for West Coast Lumber", January 1978 edition.
- B. Design: Grade combination 24f, finger jointing on wide face of lamination are permitted providing fabrication is in strict accordance with AITC 17-71 Specifications. Lumber free of characteristics which interfere with uniform bending to required curvature. Lumber properly kiln dried for glue laminating; moisture content not less than 7% but not exceeding 14%. The range of moisture content of various lamination assembled into a single member shall not exceed 5%.
- C. Adhesive: Resorcinol formaldehyde, conforming to Military Specification MIL-A-3978, Type I, Class I, Exterior (general service) Grade A.
- D. Grade: All members shall be Industrial Appearance Grade. All filler shall be natural wood filler. No synthetic fillers allowed. All exposed surfaces shall be resawn.
- E. Pressure Treatment: (where required) Standards C1 & C2 of the American Wood Preservers Association (AWPA) latest edition.
- F. Hardware: Provide all connection steel, metal brackets, hardware, bolts, etc. required for the assembly and erection of work specified under this Section.

PART 3 - EXECUTION

3.01 FABRICATION

- A. Fabricate all products of this Section in strict accordance with the referenced Standards, the original design, and the Shop Drawings bearing the Reviewer's Final Stamp.
- 3.02 INSTALLATION**
- A. Surface Conditions: Prior to installation of work of this Section, carefully inspect the installed work of all other trades and verify that all such work is complete to the point where this installation may properly commence. In the event of discrepancy, immediately notify the Architect.
- B. Erection of glued laminated members: Use only that equipment which is of the proper design and capacity and only such personnel as are completely familiar with the method of erection. Properly and adequately shore and brace all glued laminated beams. Leave all shoring and bracing in place until this work and all other work necessary to provide stability for the structure is complete. All members shall be accurately and securely installed in place with proper fastenings. Center as required. When camber is not indicated verify with the Engineer prior to fabrication.

STRUCTURAL ENGINEERING

1719 ZANKER ROAD
SUITE 103
SAN JOSE
CALIFORNIA 95128

408-438-8288

MILPITAS SENIOR CENTER PHASE 2

160 North Main
Milpitas, California
95035-3368
Phone 408-438-8288

RECORD DRAWING
4-1-83

PHASE 2	7-17-91
ISSUE FOR REVIEW	10-22-91
ISSUE FOR CONSTRUCTION	12-14-91

REVISION	DATE
----------	------

SPECIFICATIONS

JOB# : 90-001

DRAWN : MC

DATE : 7-17-91

SCALE : NONE

S5.3

2 - 913